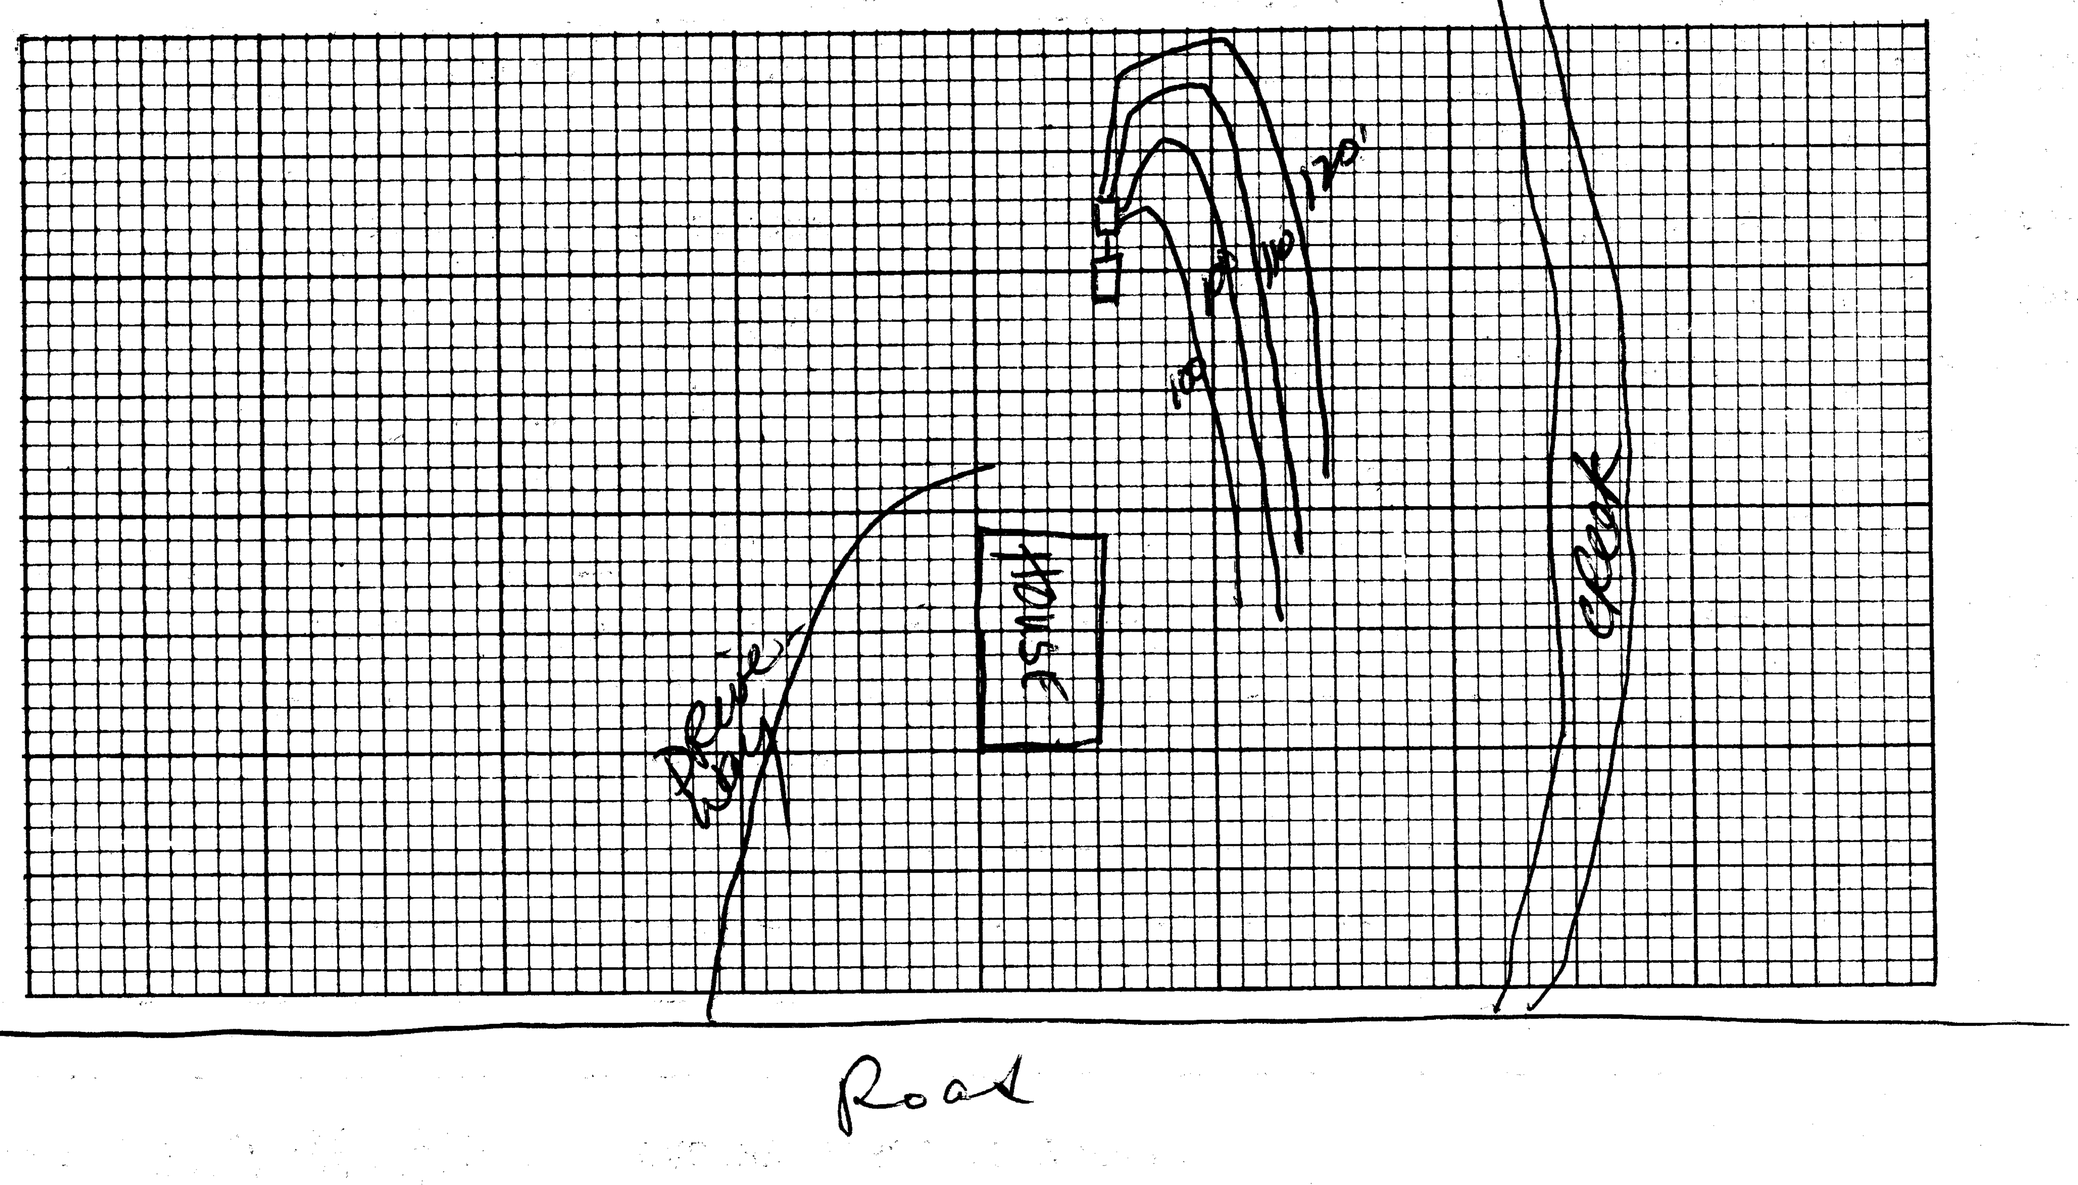NOTE: Make sketch of installation showing location of house, septic tanks, privies, water supplies on adjacent property, etc. Write in measurements in order that installations may be located at later date.