510-11

Tax Map No. 322 Parcel No. 376 Permit No. B27173 Date 9-29-83 By James R. Bass

TION

al ( ) Subdivision ( ) Other
Approval
Dwelling

Zoning R-4

Road No. | Flood Plain ( ) Yes ( ) No

Phone | Street address 8116 Brentwood Ct.

Health Department)

f other rooms w/closets ___

f other rooms w/closets ___

rooms | No. of other rooms with closets ___

Waste- water ( ) Domestic ( ) Industrial

( ) Addition

No

( ) Private off-site

roposed structures (including

ure.

Telephone No.

Telephone No.

lication and any attached documents
ledge and belief and are made in
e grounds for rejection of this
ves are granted right of entry
rmation upon public request.

9/29/83
Date

Land use indicated (is) (is not) permitted in the zoning district. If permitted, the following minimum zoning requirements must be met, unless the Health Department requires more land area or other qualifications are indicated in the remarks.

	square feet		Front yard depth ___ ft.		Corner yard depth ___ ft.		Aggragate both sides ___
Lot area	___	Side yard	___	Rear yard	___		
Lot width	___ feet	depth	___ ft.	depth	___ ft.		

Remarks: ___

Signature of Owner or Authorized Agent

Zoning Administration Division
Jurisdiction

9-26-83
Date

Processed by

WAKE COUNTY HEALTH DEPARTMENT SEPTIC TANK LAYOUT AND PERMIT

PERMIT NO. B

TAX MAP NO. 322 PARCEL NO. 376

CONTRACTOR [illegible]

OWNER [illegible]

LOCATION 8116 Brentwood

DATE [illegible]

SUBDIVISION NAME [illegible] LOT NO. 14 S. R. NO. [illegible]

SECTION OR BLOCK NO. ___

REPAIR ☐ ORIGINAL PERMIT NO. ___

GARBAGE DISPOSAL UNIT YES ☐ NO ☒

HOUSE ☐ MOBILE HOME ☐ BUSINESS ☐

NO. BEDROOMS [illegible] LOT AREA [illegible] sq. ft.

SIZE OF TANK [illegible] gal.

NITRIFICATION LINE [illegible] sq. ft.

DEPTH OF STONE IN LINES: 12" ☐

RISER AND BAFFLE REQUIRED ☒ PUMP REQUIRED ☐

WATER SUPPY: INDIVIDUAL ☐ PUBLIC ☒ OTHER ☐

* PERMIT VOID 36 MONTHS FROM DATE OF ISSUANCE.
* PERMIT VOID IF NOT IN COMPLIANCE WITH ZONING REGULATIONS
* PERMIT MAY BE VOIDED IF SITE ALTERATIONS MADE

LAYOUT BY [illegible]

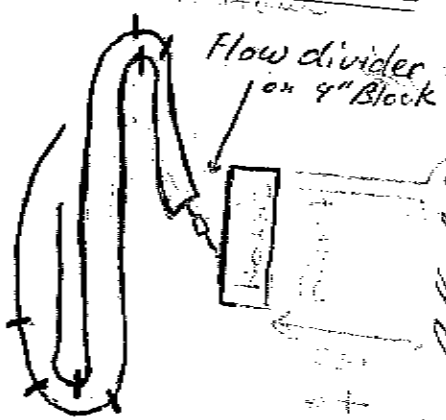

5-2-84
DATE

Thomas Construction
INSTALLED BY
469 3757

APPROVED BY

590-GP09