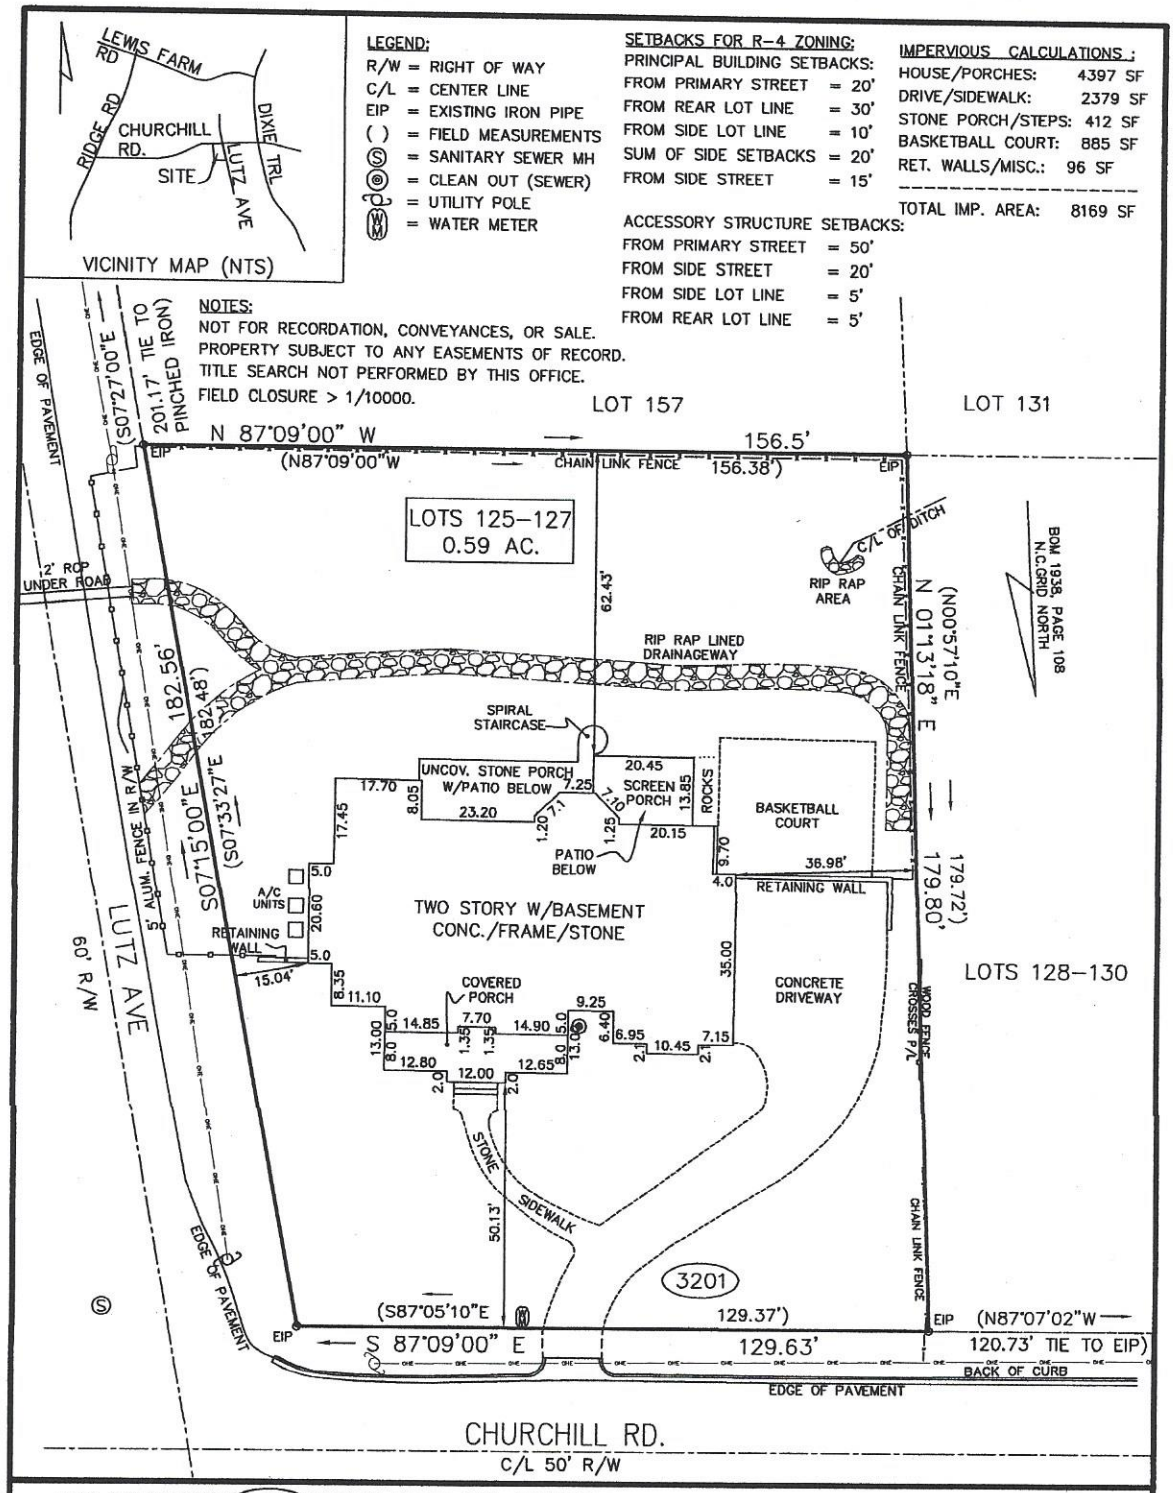

THIS PROPERTY ~~IS~~ IS NOT LOCATED IN AN AREA DESIGNATED AS HAVING SPECIAL FLOOD HAZARDS ACCORDING TO FLOOD INSURANCE RATE MAP #3720079400 J . EFFECTIVE DATE: MAY 2, 2006.

LOT 125-7 BLOCK _____ SECTION _____

SUBDIVISION RALINA

RECORDED IN BOOK OF MAPS 1938 PAGE 108 WAKE COUNTY REGISTRY

AS-BUILT

SAW/MW
2014124

I, SONYA A. WARD, HEREBY CERTIFY THAT THIS MAP IS CORRECT, THAT THE BUILDINGS LIE WHOLLY ON THE LOT, AND THAT THERE ARE NO ENCROACHMENTS OF OTHER BUILDINGS ON THE SAID LOT EXCEPT AS SHOWN ON SURVEY.

CAROLINA
SEAL
L-4017
LAND SURVEYOR
SONYA A. WARD

SURVEY FOR:

DAVE ZAAS

RALEIGH TOWNSHIP WAKE COUNTY NC

SCALE: 1"=30'

DATE: 09/14/15

BOOK #: 293p72

WARD SURVEYING SERVICES, PLLC
LAND SURVEYING & PLANNING
APEX, N.C. (919) 367-7858