Environmental Services - Water Quality
Onsite Wastewater Scan Data Entry Form

PERMIT #: 0020485 PIN #: 0699615597

OP DATE: 06/28/2001

SYSTEM USE:
- [x] House
- [ ] Mobile Home
- [ ] Business
- [ ] Other

SEWAGE TYPE:
- [x] Domestic
- [ ] Industrial

PUMP/SIPHON?:
- [ ] Yes
- [x] No

PRESSURE MANIFOLD:
- [ ] Yes
- [x] No

SYSTEM TYPE:
- [ ] I
- [x] II
- [ ] III
- [ ] IV
- [ ] V
- [ ] VI
- [ ] Other

SUB TYPE:
- [x] A
- [ ] B
- [ ] C
- [ ] D
- [ ] E
- [ ] F
- [ ] G

NBR BEDROOMS:
- [ ] 1
- [ ] 2
- [x] 3
- [ ] 4
- [ ] 5
- [ ] 6
- [ ] Other

MAINT. SCHEDULE:
- [ ] Yes
- [x] No

CERT. OPERATOR
- [ ] Yes
- [x] No

GT	ST	PT	SIZE
☐	☐		750
☐	☐	☐	900
☐	☒	☐	1,000
☐	☐	☐	1,200
☐	☐	☐	1,500
☐	☐	☐	1,800
☐	☐	☐	2,100
☐	☐	☐	2,500
☐	☐	☐	3,000
☐	☐	☐	4,000
☐	☐	☐	5,000
☐	☐	☐	8,000
	☐	☐	10,000
☐	☐	☐	Other
☒		☒	None/NA GT or PT

DRAINFIELD SIZE(SQ. FT.)
01200

DRAIN TYPE:
- [x] Stone
- [ ] EZ Flow
- [ ] Infiltrator
- [ ] Biodiffuser
- [ ] Cultec
- [ ] Drip
- [ ] Hancor
- [ ] Large Dia. Pipe
- [ ] Multi-Pipe
- [ ] Other

MAX DEPTH (IN.):
- [ ] 12 in. or less
- [ ] 18 in. or less
- [x] 24 in. or less
- [ ] 26 in. or less
- [ ] 28 in. or less
- [ ] 30 in. or less
- [ ] 32 in. or less
- [ ] 36 in. or less
- [ ] Other

STONE DEPTH (IN.):
- [ ] 8 in. or less
- [x] 12 in. or less
- [ ] 18 in. or less
- [ ] 24 in. or less
- [ ] Other

TRENCHES:
- [x] Individual
- [ ] Bed

TRENCH WIDTH (IN.):
- [ ] 12 in. or less
- [ ] 18 in.
- [ ] 24 in.
- [x] 36 in.
- [ ] 6 ft. or less
- [ ] 9 ft. or less
- [ ] Other

BW 11/18/13

WAKE COUNTY DEPARTMENT OF ENVIRONMENTAL SERVICES WELL AND SEWAGE SITE LOCATION PERMIT
NO PERMIT(S) FOR CONSTRUCTION, LOCATION OR RELOCATION ACTIVITY SHALL BE ISSUED
UNTIL AN AUTHORIZATION FOR WASTEWATER SYSTEM CONSTRUCTION HAS BEEN ISSUED
PERMIT VOID IF NOT IN COMPLIANCE WITH ZONING REGULATIONS AND/ OR IF SITE IS ALTERED OR INTENDED USE CHANGED

PERMIT#: **D020485** STATUS: **A** APP. DATE: **01/19/2001** BLDG. PERMIT#: **0012286**
PIN: **0699.04 61 5597 000** TAX MAP: **0767** RECORDED: **Y** ORIG. PERMIT#:
TOWNSHIP: **15 PANTHER BRANCH** JURISDICTION: **WC** ZONING: **R30**
APPLICANT: **CANADIAN HOMES**
1613 HARMONT DR
RALEIGH, NC 27603
(919) 779 - 9532
USE: HD USE: **101 ONE-FAMILY HOUSE**
EXIST USE:
DISPOSAL: **Y** BEDROOMS: **3** BASEMENT: **N** #EMPLOYEES: **0**
SITE: ADDRESS: **1201 ROLLING FARM DR**
SUBDIVISION: **OLD STAGE PLACE** LOT: **12** ACRES: **1.05**
DIRECTION: **401S L SR 1006 CROSS SR 1010 R INTO SUB**

Well System: WATER: **COMMUNITY** - TYPE: **NEW**

WELL LOG INFORMATION: DEPTH: ____ CASING DEPTH: ___ YIELD: _____ STATIC LEVEL: _____
WELLI CONTRACTOR: _____ REG.# _____ PUMP CONTRACTOR: _____ REG.# _____
Construction Compliance GROUT APPROVED ☐ DATE _____ EHS _____
WELLHEAD APPROVED ☐ DATE _____ EHS _____
SYSTEM FINALIZED ☐ DATE _____ EHS _____
COMMENTS:

Operation Permit

DESIGN FLOW: _____ gal./min. ACTUAL FLOW: _____ INNOVATIVE LETTER: N/

INSTALLED BY: _____ INSTALLATION APPROVED BY: Vincent J. Manzi RS.
PROPRIETARY SYSTEM: FILTER NO: _____
COMMENTS:

OPERATIONS PERMIT ISSUED? X OP DATE: 6/28/01 BY: Vincent J. Manzi RS

This permit is based in part on information provided by the homeowner or his/her representative in the application submitted for this permit. The Environmental Health Specialist is not responsible for false or misleading information contained in the application. The Environmental Health Specialist is also not responsible for concealed conditions on the property or for statements in this report that may have resulted from false or misleading statements provided to him in the application. Neither Wake County nor the Environmental Health Specialist warrants that the septic tank system will continue to function satisfactorily in the future or that the water supply will remain potable.

WAKE COUNTY DEPARTMENT OF ENVIRONMENTAL SERVICES WELL AND SEWAGE SITE LOCATION PERMIT
NO PERMIT(S) FOR CONSTRUCTION, LOCATION OR RELOCATION ACTIVITY SHALL BE ISSUED
UNTIL AN AUTHORIZATION FOR WASTEWATER SYSTEM CONSTRUCTION HAS BEEN ISSUED
PERMIT VOID IF NOT IN COMPLIANCE WITH ZONING REGULATIONS AND/ OR IF SITE IS ALTERED OR INTENDED USE CHANGED

PERMIT#: **D020485** STATUS: **A** APP. DATE: **01/19/2001** BLDG. PERMIT#: **0012286**
PIN: **0699.04 61 5597 000** TAX MAP: **0767 0000** RECORDED: **Y** ORIG. PERMIT#:
TOWNSHIP: **15 PANTHER BRANCH** JURISDICTION: **WC** ZONING: **R30**
APPLICANT: **CANADIAN HOMES**
1613 HARMONT DR
RALEIGH, NC 27603
(919) 779 - 9532
USE: HD USE: **101 ONE-FAMILY HOUSE**
EXIST USE:
DISPOSAL: **Y** BEDROOMS: **3** BASEMENT: **N** #EMPLOYEES: **0**
SITE: ADDRESS: **1201 ROLLING FARM DR**
SUBDIVISION: **OLD STAGE PLACE** LOT: **12** ACRES: **1.05**
DIRECTION: **401S L SR 1006 CROSS SR 1010 R INTO SUB**

IMPROVEMENT PERMIT

TANK SIZE: **1000** gal. PUMP Tank: _____ gal. SQ FT: **1200** STONE DEPTH: **12 in.** MAX DEPTH LINE: **24** in.
WASTEWATER: **INDIVIDUAL** SEWAGE: **DOMESTIC** TYPE SYSTEM: **II A** PUMP: **N** P/M: **N**
DAILY FLOW: **00360** gal/day WATER: **COMMUNITY**

COMMENTS:

IP ISSUED? **Y** DATE: **02/10/2001** BY: (SCR) Scott Keen RS PHONE#:

AUTHORIZATION FOR WASTEWATER/WATER SYSTEM CONSTRUCTION
VOID SIXTY (60) MONTHS FROM DATE OF ISSUANCE
AUTHORIZATION CONDITIONS:

Contractors shall install system on contours, see attached site plan for wastewater system design and well location. No underground utilities, water lines or sprinkler systems may be located in the original system or repair areas. A septic tank filter with a riser for access is required. The wastewater system shall not be covered or placed into use until inspected by the Wake County Department of Environmental Services and an Operation Permit issued. **OTHER CONDITIONS:**
INITIAL SYSTEM 5 80 FT CONVENTIONAL LINES. REPAIR MAY REQUIRE LPP WHEN NEEDED.INITIAL SYSTEM FLAGGED OUT IN FIELD BUT CONTRACTOR MAY NEED TO REESTABLISH CONTOURS. IF GRAVITY FLOW TO SEPTIC SYSTEM CANNOT BE MAINTAINED A PUMP WILL BE REQUIRED. MAINTAIN PROPER SETBACKS IF FOUNDATION DRAIN IS INSTALLED.

TANK SIZE: **1000** gal. PUMP TANK: _____ gal. SQ FT: **1200** STONE DEPTH: **12 in.** MAX DEPTH LINE: **24** in.
MAINT: **N** OPER: **N** L/O: **Y** TRENCH#: **5** LENGTH: **80** ft. WIDTH: **36** in.
SUBFIELDS: __ DESIGN HEAD PRESSURE: _ DESIGN FLOW: _____ gal/min DOSE VOLUME: ____ gal.

CA ISSUED? **Y** DATE: **02/10/2001** BY: (SCR) Scott Keen RS PHONE#: 857-9355

LOT 12 OLD STAGE PLACE

DATE 7/13/99

SCALE 1" = 40'

CA. Site Plan

- 5 3'x80' gravel lines
- 24" trenches
- 1000 gal S.T.

Zoning R30 By JJL

Approve ✓ Date 11/9/01

Revise _____ Use 101

Reject _____ MBL _____

Front 15 Rear 30

Side 5 Corner _____

Comments: CLUSTER SUB

NOTE: SYSTEMS ARE DRAWN IN APPROXIMATE LOCATION – LINES ARE NOT FIELD LOCATED

he location of planned or existing
accurately shown. I understand
structures in accordance with the
ay require the relocation of
gardless degree of completion. I
permission to Municipal/County
s the right of entry to make
nspections upon this property.

Robert Ehart

e of Owner or Authorized Agent

PIN: 0699.04-61-5597

00122810

D2485

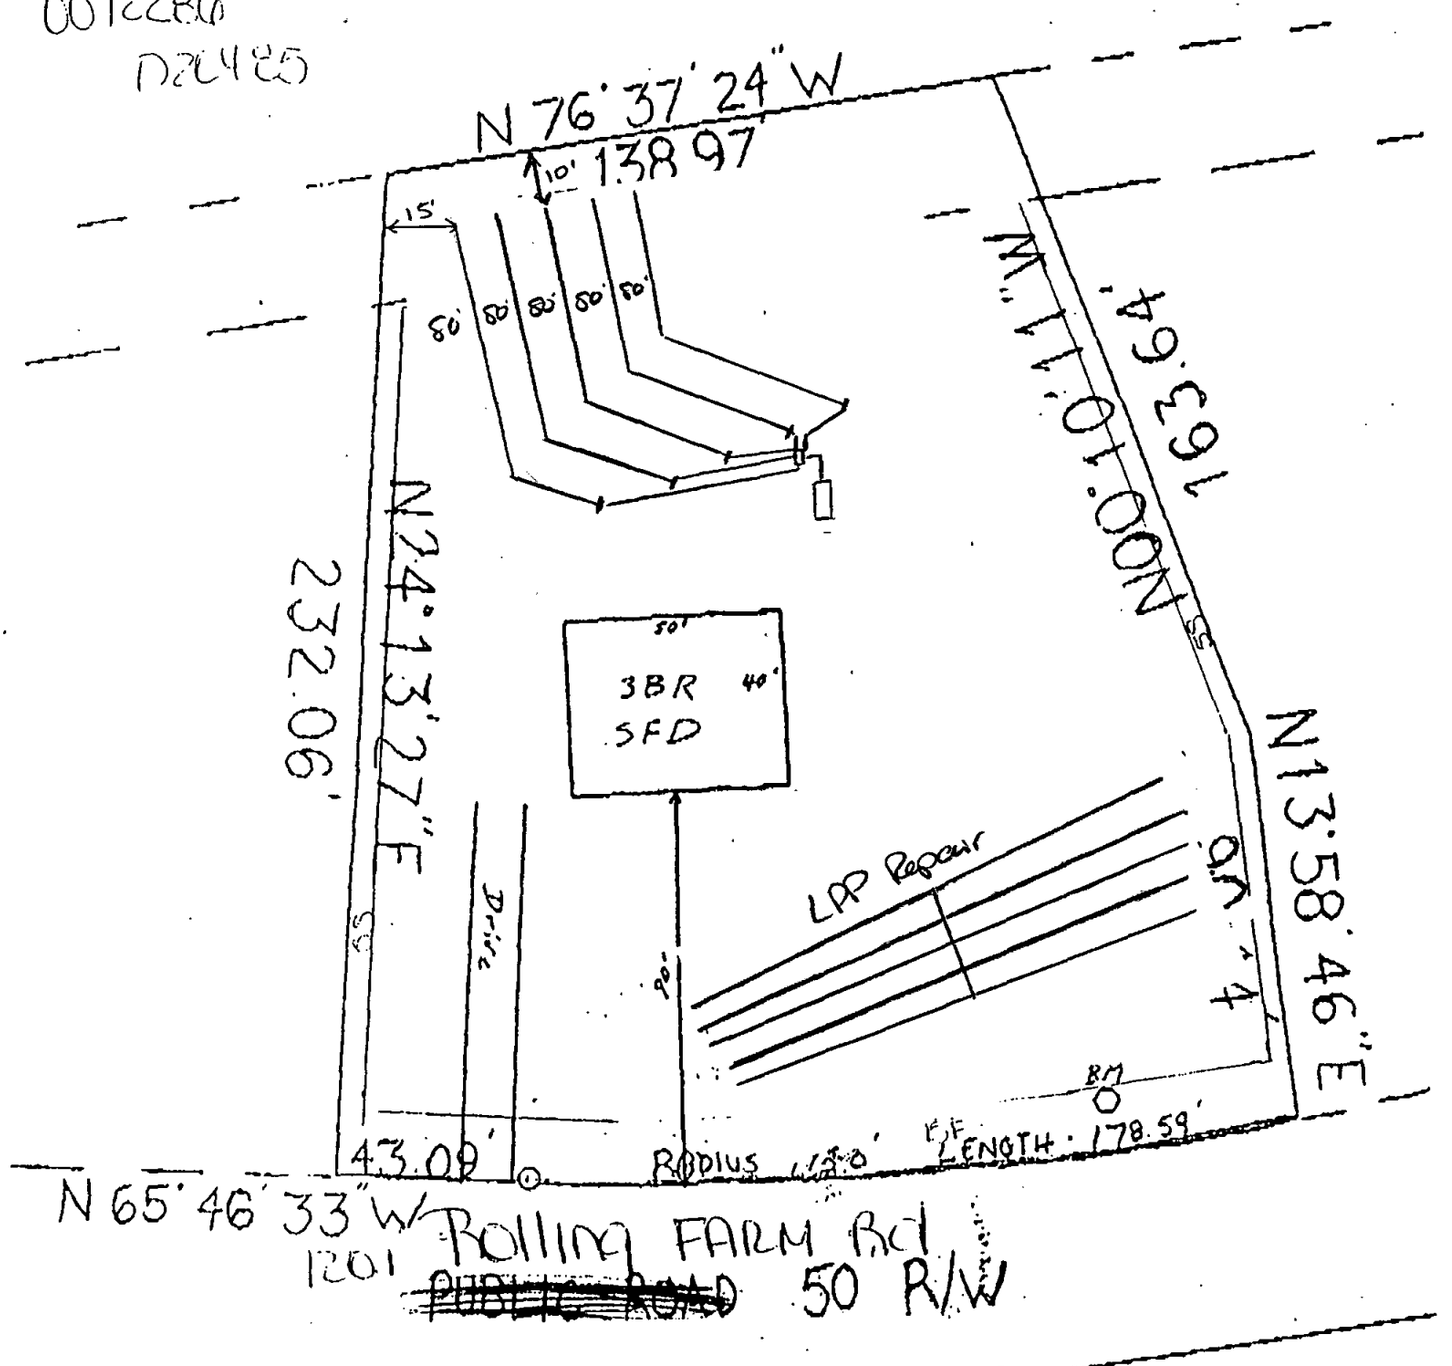

N 65° 46' 33" W

1201 Rolling FARM Rd

~~PUBLIC ROAD~~ 50 R/W