* PERMIT VOID IF NOT IN COMPLIANCE WITH ZONING REGULATIONS

WAKE COUNTY HEALTH DEPARTMENT
SEPTIC TANK LAYOUT AND PERMIT

PERMIT NO. **B 1799**

OWNER OR CONTRACTOR Charles Prince DATE Nov 7 1972

LOCATION 4015 - to SR1010 - turn left & straight to SR 2723 - turn right - straight along approx 2.3 mi - on right (approx. 3/4 mi pass xrds of SR2724

S. R. NO. 2723

SUBDIVISION NAME _____ LOT NO. _____ SECTION OR BLOCK NO. _____

GARBAGE DISPOSAL UNIT YES ☐ NO ☒

HOUSE ☒ MOBILE HOME ☐ BUSINESS ☐

NO. BEDROOMS 3BR LOT AREA 1 ACRE

SIZE OF TANK 900 gal.

NITRIFICATION LINE 900 (150'X6') sq. ft.

DEPTH OF STONE IN LINES: 12" ☒ 18" ☐

WATER SUPPLY: INDIVIDUAL ☒ PUBLIC ☐

* PERMIT VOID 12 MONTHS FROM DATE OF ISSUANCE.

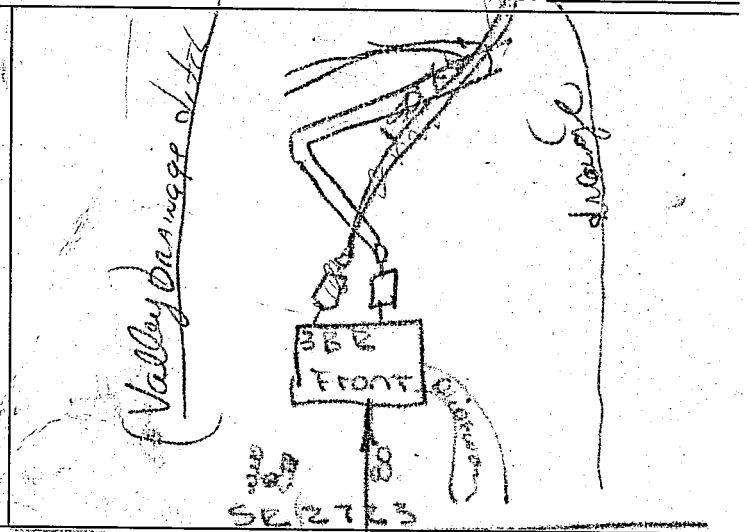

LAYOUT BY Samuel H. M. [illegible]

9/10/73
DATE

Junious Gulley
INSTALLED BY

[illegible]
APPROVED BY

* PERMIT VOID IF NOT IN COMPLIANCE WITH ZONING REGULATIONS

WAKE COUNTY HEALTH DEPARTMENT
SEPTIC TANK LAYOUT AND PERMIT

PERMIT NO. **B 1799**

OWNER OR CONTRACTOR Charles Prince DATE Nov 7 1972

LOCATION 1015 - to SR1010 - turn left & straight to SR 2723 - turn right - straight above arrow 2.3 mi - on right (approx. 3/4 mi pass xrds of SR2724

S. R. NO. 2723

SUBDIVISION NAME _____ LOT NO. _____ SECTION OR BLOCK NO. _____

GARBAGE DISPOSAL UNIT YES ☐ NO ☒

HOUSE ☒ MOBILE HOME ☐ BUSINESS ☐

NO. BEDROOMS 3BR LOT AREA 1 ACRE

SIZE OF TANK 900 gal.

NITRIFICATION LINE 900 (150' X 6') sq. ft.

DEPTH OF STONE IN LINES: 12" ☒ 18" ☐

WATER SUPPLY: INDIVIDUAL ☒ PUBLIC ☐

* PERMIT VOID 12 MONTHS FROM DATE OF ISSUANCE.

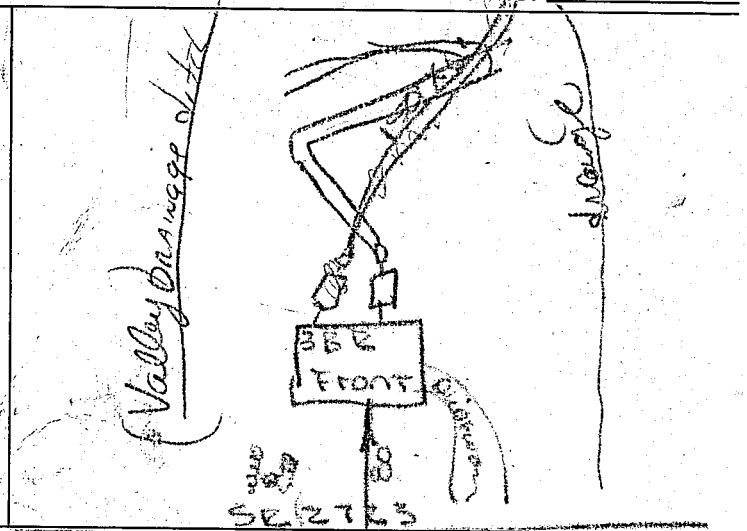

LAYOUT BY Samuel H. M. [illegible]

9/10/73
DATE

Junious Gulley
INSTALLED BY

[illegible]
APPROVED BY