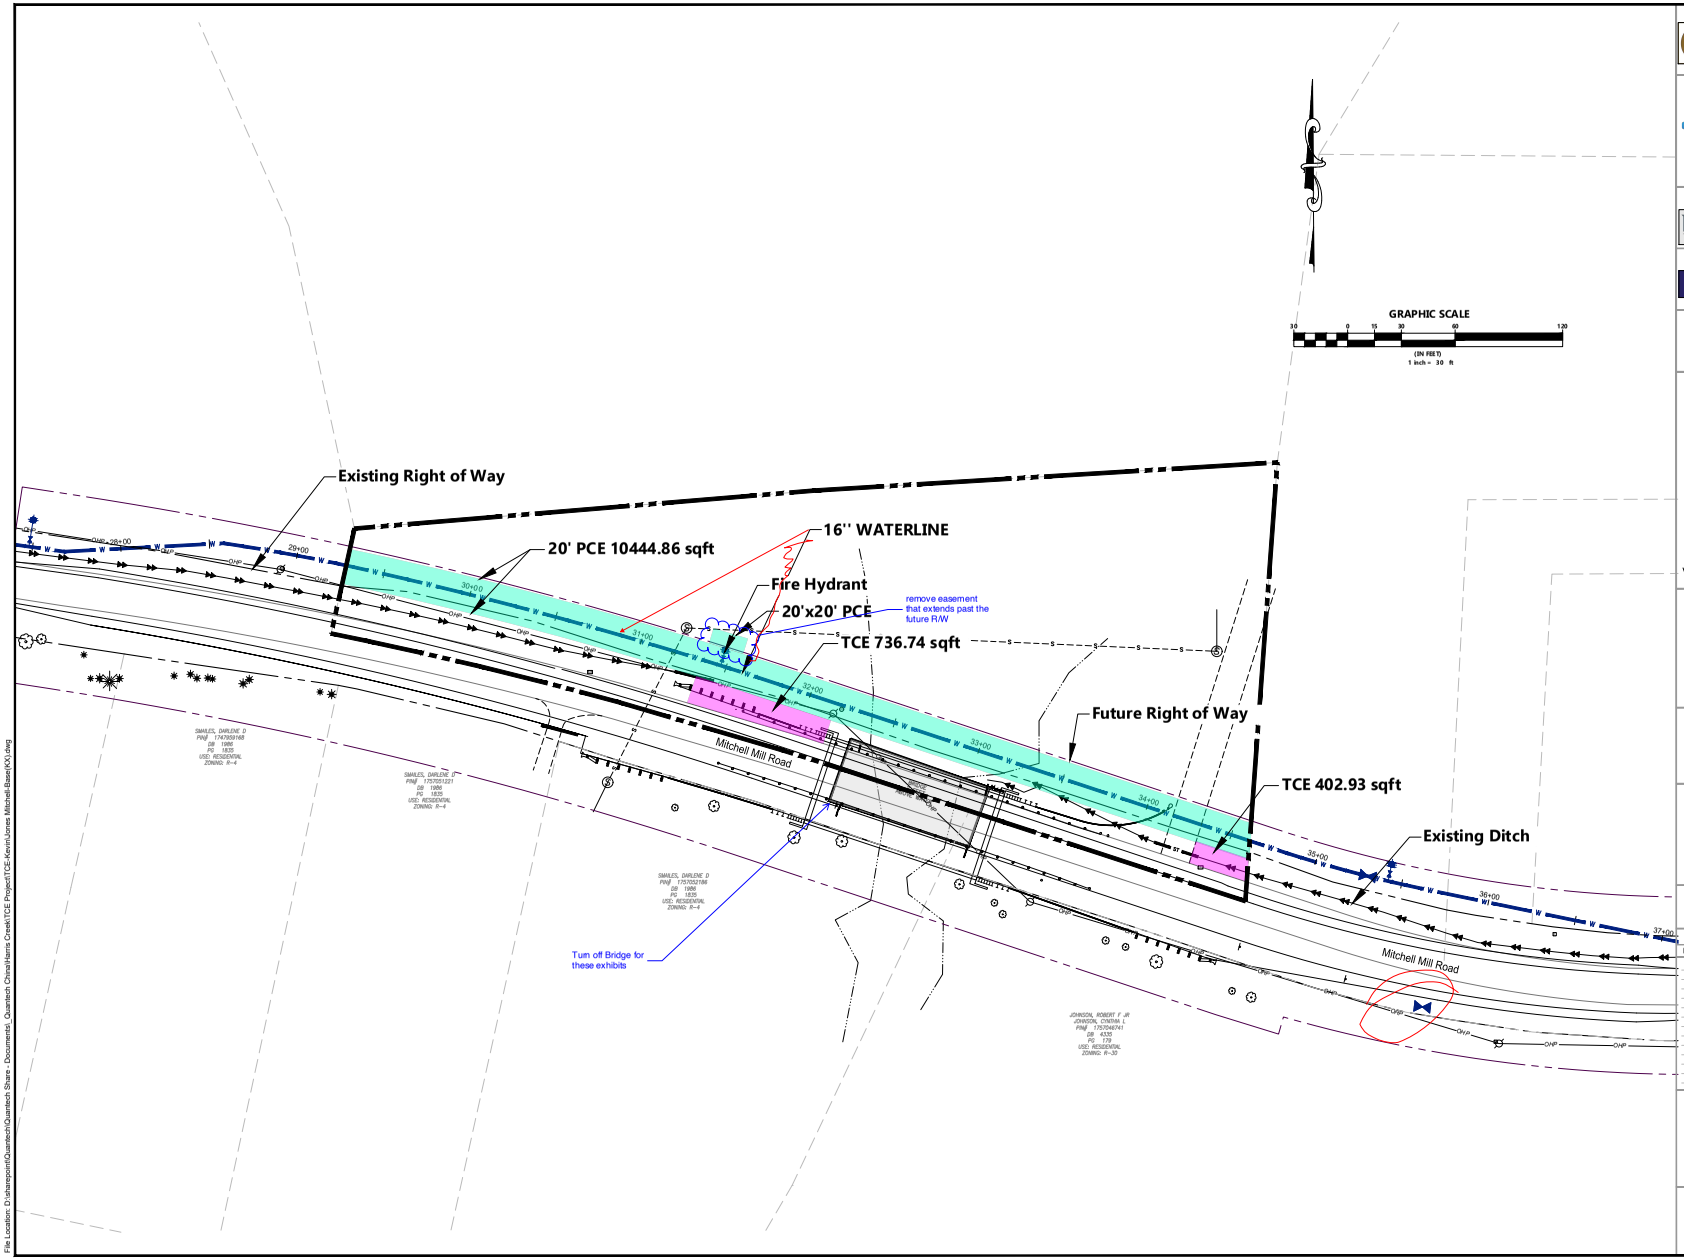


File Location: D:\sharepoint\Quantech\Quantech Share - Documents_Quantech China\Harris Creek\TCE Project\TCE-Kevin\Jones Mitchell-Base(KX).dwg

Developer
THE CSC GROUP
275 Carpenter Hill Lane Cary, NC 27519

Engineer
QUANTECH ENGINEERING
Firm # P-1517
3725 National Dr
Raleigh, N.C. 27612
(919) 996-9455

Surveyor
MURPHY GEOMATICS
Murphy Geomatics
4850 Paragon Park Rd
Raleigh, NC 27616
919-787-7873

Jurisdiction / Municipality
WENDELL
Town of Wendell
409 Landing View Dr.
Wendell, NC 27591
919-365-4450

Jurisdiction / Municipality (Utilities)
Raleigh Water
Raleigh Water
222 W. Hargett St.
Raleigh, NC 27601
919-996-3245

Sheet map:

N
W E
S

Seal:

FINAL DRAWING - FOR REVIEW PURPOSES ONLY

Issued / Print Date: 17/04/2026
File Name: JONES MITCHELL-BASE(KX).DWG

Last Saved by: 23623
Drawn by: JAC

Project:

HARRIS CREEK

Issued for:
CONSTRUCTION PLAN REVIEW
DO NOT USE FOR CONSTRUCTION

REVISIONS

No.	Date	Description

Sheet Title:

Sheet #: