Environmental Services - Water Quality
Onsite Wastewater Scan Data Entry Form

PERMIT #: D 0 0 0 1 1 7 PIN #: 1 6 0 7 2 7 6 4 0 3

OP DATE: 0 6 1 0 6 1 1 9 9 6

SYSTEM USE:
- [x] House
- [ ] Mobile Home
- [ ] Business
- [ ] Other

SEWAGE TYPE:
- [x] Domestic
- [ ] Industrial

PUMP/SIPHON?:
- [x] Yes
- [ ] No

PRESSURE MANIFOLD:
- [ ] Yes
- [x] No

SYSTEM TYPE:
- [ ] I
- [ ] II
- [x] III
- [ ] IV
- [ ] V
- [ ] VI
- [ ] Other

SUB TYPE:
- [ ] A
- [x] B
- [ ] C
- [ ] D
- [ ] E
- [ ] F
- [ ] G

NBR BEDROOMS:
- [ ] 1
- [ ] 2
- [x] 3
- [ ] 4
- [ ] 5
- [ ] 6
- [ ] Other

MAINT. SCHEDULE:
- [ ] Yes
- [x] No

CERT. OPERATOR
- [ ] Yes
- [x] No

GT	ST	PT	SIZE
☐	☐		750
☐	☐	☐	900
☐	☒	☒	1,000
☐	☐	☐	1,200
☐	☐	☐	1,500
☐	☐	☐	1,800
☐	☐	☐	2,100
☐	☐	☐	2,500
☐	☐	☐	3,000
☐	☐	☐	4,000
☐	☐	☐	5,000
☐	☐	☐	8,000
	☐	☐	10,000
☐	☐	☐	Other
☒		☐	None/NA GT or PT

DRAINFIELD SIZE(SQ. FT.)

0 1 2 0 0

DRAIN TYPE:
- [x] Stone
- [ ] EZ Flow
- [ ] Infiltrator
- [ ] Biodiffuser
- [ ] Cultec
- [ ] Drip
- [ ] Hancor
- [ ] Large Dia. Pipe
- [ ] Multi-Pipe
- [ ] Other

MAX DEPTH (IN.):
- [ ] 12 in. or less
- [ ] 18 in. or less
- [ ] 24 in. or less
- [ ] 26 in. or less
- [ ] 28 in. or less
- [x] 30 in. or less
- [ ] 32 in. or less
- [ ] 36 in. or less
- [ ] Other

STONE DEPTH (IN.):
- [ ] 8 in. or less
- [x] 12 in. or less
- [ ] 18 in. or less
- [ ] 24 in. or less
- [ ] Other

TRENCHES:
- [x] Individual
- [ ] Bed

TRENCH WIDTH (IN.):
- [ ] 12 in. or less
- [ ] 18 in.
- [ ] 24 in.
- [x] 36 in.
- [ ] 6 ft. or less
- [ ] 9 ft. or less
- [ ] Other

NOT FOR WASTEWATER SYSTEM CONSTRUCTION Anthony Leggette

WAKE COUNTY HEALTH DEPARTMENT WELL AND SEWAGE SITE, LOCATION PERMIT 12-16-98

NO PERMIT(S) FOR CONSTRUCTION, LOCATION OR RELOCATION ACTIVITY SHALL BE ISSUED UNTIL AN AUTHORIZATION FOR WASTEWATER SYSTEM CONSTRUCTION HAS BEEN ISSUED

Pin # 1607.01 276403 Project # 0960980 Improvement Permit D117

Tax Map No. _____ Parcel No. _____ Well Permit No.

Zoning Wake Township Panther Branch Operation Permit [ ]

Owner/Contractor: William T. Barker Date: 10-12-95

Location/Address: (6225 Hampton Ridge Rd) 401 S, (L) old Stage Rd, (R) Holland Ch, (L) Pagan, (R) 3rd, 1st on left S.R. # 2737

Subdivision Name: Hampton Ridge Lot No. 145 Section or Block No. _____

Tax Map No. _____ Parcel No. _____ PIN # 1607.01 276403

Preliminary Layout

* see attached plat for wastewater disposal site

* see Construction authorization for wastewater system design:
4-19-96 check list 90' trench.
4-15-96 - trench inspection
Backfilled prior to skedulled inspection due to V. heavy rain in afternoon
-90 feet trench

Final Layout (Hold For Pump Final)

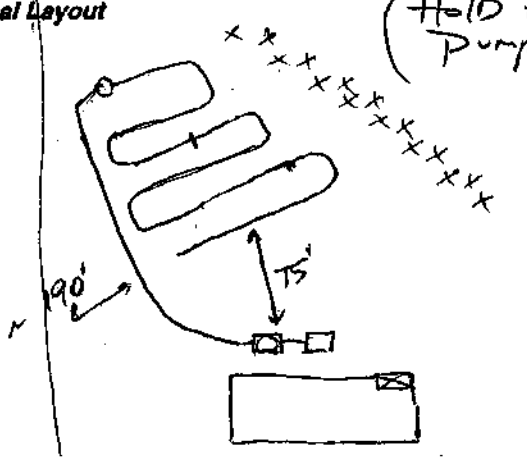

-to fill (3'x400')

Sewage System Specifications

Repair [ ] Original Permit No. _____

Garbage Disposal Unit Yes [ ] No [ ]

House [✓] Mobile Home [ ] Business [ ]

No. of Bedrooms 3 Lot Area .78

Size of Tank 1000 ST + 1000 PT gal.

Wastewater: Sewage [✓] Industrial [ ] Comments: Installed 1200ft 1(3'x400')

Nitrification Line 1200ft² 2(3'x200') sq. ft.

Depth of Stone: 12" [4] Max Depth of Trenches: 30 in.

Riser and Baffle Required [✓] Pump Required [✓]

☛ Permit void if not in compliance with zoning regulations

☛ Permits may be voided if site is altered or intended use changed

Layout by: Terry D. Chappell R.S.

Date: 6/6/96 Installed By: R. EBENHART Approved By: _____

Well System

Individual [ ] Semi-Public [ ] Public [✓]
New [ ] Replacement [ ] Repair [ ]
Fee Paid: Yes [ ] No [ ]

Construction Compliance	Yes	No
Site Approved	[ ]	[ ]
Well Head Approved	[ ]	[ ]
Grouting Approved	[ ]	[ ]

Date Inspected _____ Sanitarian _____

Bacteriological Results

Initial Sample: _____ Date: _____
* Re-Sample #1 _____ Date: _____
* Re-Sample #2 _____ Date: _____
* Re-chlorination as required [ ] Yes [ ] No
* Fees for all resamples

All checks payable to: **Wake County Health Department**

Final Inspection	Yes	No
Required Slab	[ ]	[ ]
Chlorinated	[ ]	[ ]
Required Certificate	[ ]	[ ]
Variance (Explain)	[ ]	[ ]
WCHD I.D. Affixed	[ ]	[ ]
Sample Collected	[ ]	[ ]

Comments: _____

Well Installed By: _____

Date System Finalized _____ Sanitarian _____

This report is based in part on information provided by the homeowner or his/her representative in the application submitted for this permit. The sanitarian is not responsible for false or misleading information contained in the application. The sanitarian is also not responsible for concealed conditions on the property or for statements in this report that may have resulted from false or misleading statements provided to him in the application. Neither Wake County nor the sanitarian warrants that the septic tank system will continue to function satisfactorily in the future or that the water supply will remain potable.

COPY TO HEALTH DEPARTMENT

3002.017 — 5/14/93

#.0960980

AUTHORIZATION FOR WASTEWATER SYSTEM CONSTRUCTION

VOID SIXTY(60) MONTHS FROM DATE OF ISSUANCE

DATE: 10-12-95 IMPROVEMENT PERMIT NO.: D117

TAX MAP NO.: _____ PARCEL NO.: _____ PIN NO.: 1609.01 27 6403

PIN #:

OWNER/CONTRACTOR: William T. Baker

LOCATION/ADDRESS: 6225 Hampton Ridge Rd

SUBDIVISION NAME: Hampton Ridge

LOT NO.: 145 SECTION OR BLOCK NO.: _____

AUTHORIZATION ISSUED BY: Terry D. Chappell R.S.

AUTHORIZATION CONDITIONS

1 WASTEWATER SYSTEM CONSTRUCTION AND INSTALLATION MUST MEET ALL CONDITIONS AND SPECIFICATIONS AS SET FORTH IN IMPROVEMENT PERMIT NO. D117 AND THE ATTACHED SITE PLAN WITH SYSTEM DETAILS. CONSTRUCTION AND INSTALLATION MUST ALSO MEET ALL REQUIREMENTS SET FORTH IN THE "REGULATIONS GOVERNING SANITARY SEWAGE COLLECTION, TREATMENT, AND DISPOSAL IN WAKE COUNTY" AND ANY OTHER APPLICABLE RULES AND LAWS.

2 THE WASTEWATER SYSTEM SHALL NOT BE COVERED OR PLACED INTO USE UNTIL INSPECTED BY THE WAKE COUNTY DEPARTMENT OF HEALTH AND AN OPERATION PERMIT ISSUED.

3 ANY ALTERATION IN SITE OR SOIL CONDITIONS (INCLUDING LOCATION OF STRUCTURES AND APPURTENANCES) OR MODIFICATION IN USE, DESIGN WASTEWATER FLOW, OR WASTEWATER CHARACTERISTICS AS SPECIFIED IN THE ASSOCIATED IMPROVEMENT PERMIT AND APPLICATION, MAY VOID THIS AUTHORIZATION AND ASSOCIATED PERMITS.

4 OTHER CONDITIONS: Pump system required - Use NEMA 4X Ebx box, mount on 4x4 wooden post Place Alarm in garage or in House, Use Conventional Trench, 3' width, 2 trenches 200' long, Contractor to establish Contours Mark Depth of trenches 30" Use 1000 gal septic tank & 1000 gal pump tank, See attached plot plan for location of system.

10'

0960980

#

607.01 27 6403 000

William T. Barker

821-4141

#D 117

N

Zoning R30 By DMC

Approve ✓ Date 10-4-95

Revise ___ Use 101

Reject ___ MBL 95

Front 30 Rear 30

Side 10 Corner 30

Comments:

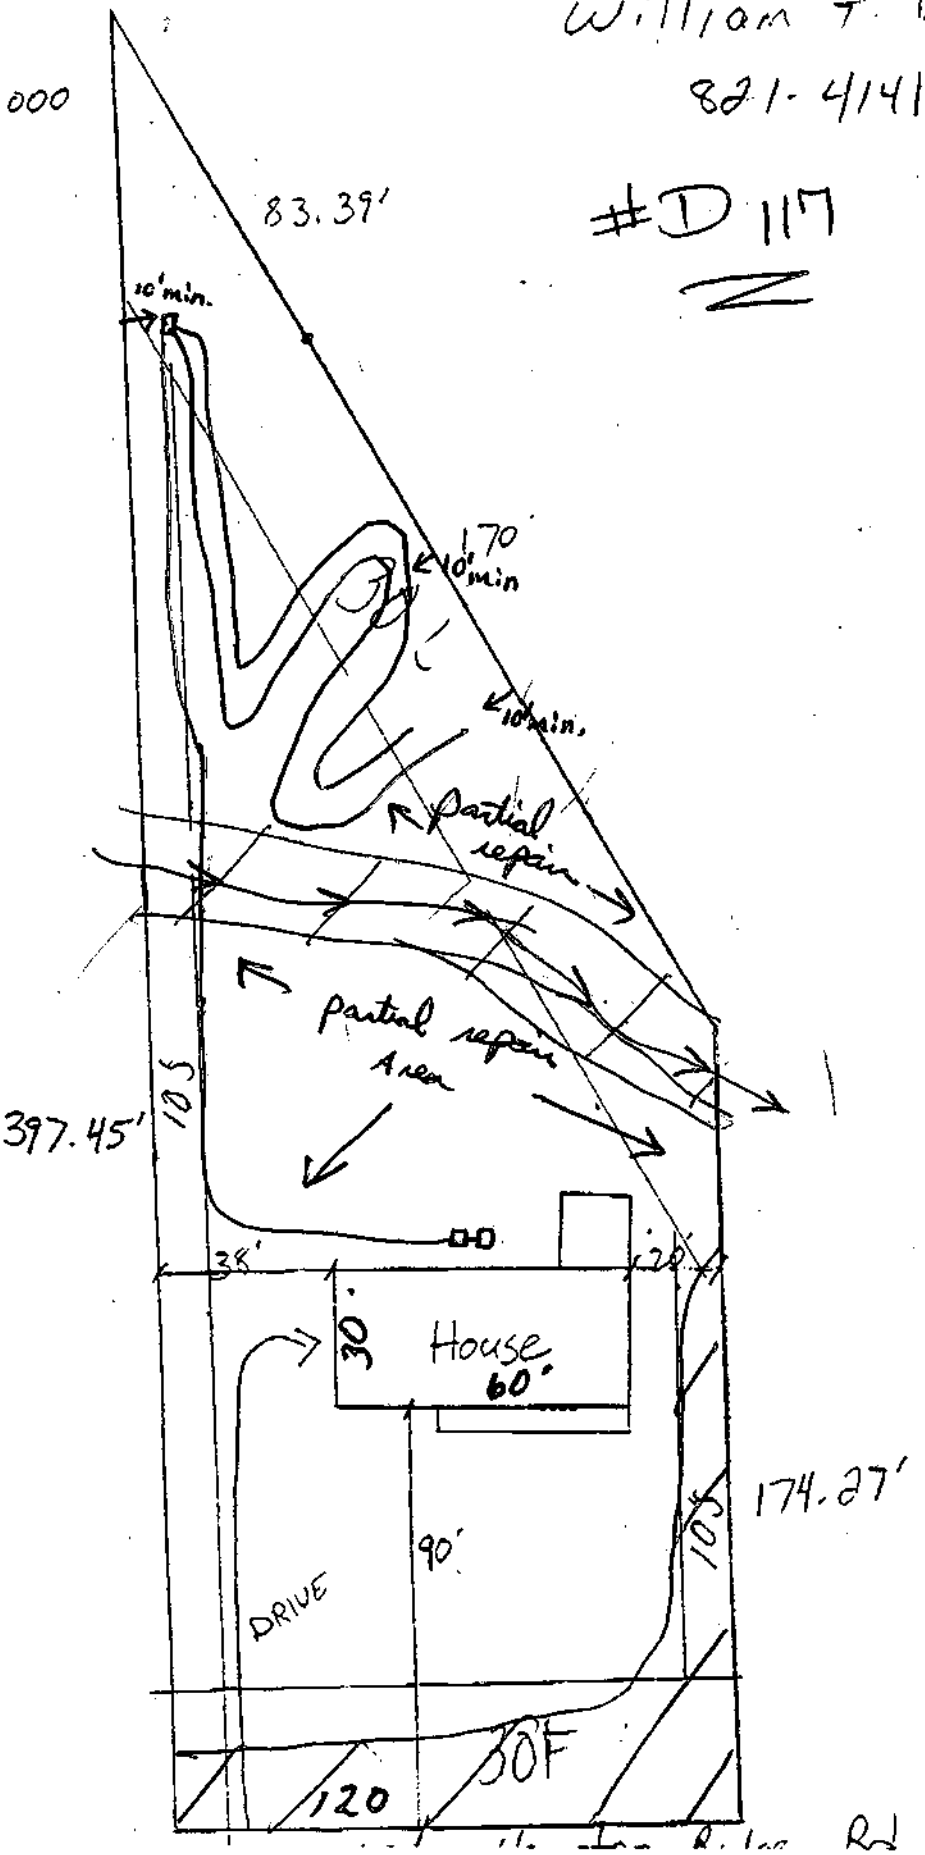

this plot plan could require relocation of the structure regardless of its degree of completion:

Signature Date

Check one: ( ) Owner (✓) Builder/Contractor ( ) Other

iMAPS

Disclaimer About Feedback

Tools

Maps

Street Map

Aerials

Labels

1999

Blend

Hampton Ridge Rd

0 30 60ft

Overview

iMAPS

Disclaimer About Feedback

Tools

Maps

Street Map

Aerials

Labels

2005

Blend

Hampton Ridge Rd

0 30 60ft

Overview

iMAPS

Disclaimer About Feedback

Tools

Maps

Street Map

Aerials

Labels

2017

Blend

Hampton Ridge Rd

0 30 60ft

Overview