OPERATION PERMIT

Franklin County Health Department
107 Industrial Drive
Louisburg, NC 27549
Phone:

For Office Use Only

*CDP File Number: 397240 - 1
County ID Number:
Evaluated For: NEW

Property Owner: TINGEN CONSTRUCTION COMPANY, INC
Owner Address: 8411 GARVEY DR

City: RALEIGH
State/Zip: NC/ 27616
Phone #:
Address: 15 OLD GARDEN LN
YOUNGSVILLE, NC 27596
Road #:
Township:
Subdivision: TARBOROUGH RIDGE
Phase : NEW Lot: 20

Structure: SINGLE FAMILY
# of Bedrooms: 4
# of People: 4
Water Supply: NEW WELL
Saprolite System?: [ ] Yes [X] No
Pump Required?: [X] Yes [ ] No
Design Flow: 480
System Classification/Description: TYPE III B. SYSTEM W/SINGLE EFFLUENT PUMP

Installer: True Works
Certification #:

Specific System Installed: EZFLOW EZ 1203H-GEO

STB: 1000

PT: 1000

Septic Tank Date: 09/28/2023

Pump Tank Date: 09/17/2023

Comments:

This system has been installed in compliance with applicable NC General Statutes, Rules for Sewage Treatment and Disposal, and all conditions of the Improvement Permit and Construction Authorization.

PERMIT CONDITIONS:

I. **Performance: System shall perform in accordance with Rule .1301.**

II. **Monitoring: As required by Rule .1301.**

III. **Maintenance: Ground absorption sewage treatment and disposal systems shall be checked, and the contents of the septic tank removed, periodically from all compartments, to ensure proper operation of the system. The contents shall be pumped whenever the solids level is found to be more than 1/3 of the liquid depth in any compartment.**

Other:

Subsurface Operator Required: [ ] Yes [X] No

If yes, see attached sheet for additional operation conditions, maintenance and reporting.

Operation:

Other:

Authorized State Agent: Bendel, Joel

Date of Issue: 01/08/2024

Owner/Applicant: _____

Franklin County
NORTH CAROLINA

File # 397240 PIN# _____

Property Address: 15 Old Garden Ln

Applicant or Owner Name: Tingen Const.

Environmental Health Septic/Well Permit Diagram

Building permits cannot be issued nor should construction begin without Construction Authorization issuance.

(X) Septic Improvement Permit (X) Septic Construction Authorization (CA) ( ) CA Reissue** (X) As Built

(X) Well Construction Authorization ( ) Additional Diagram/Specifications Attached

Diagram Date:** 7-17-23 **EHS:** Joel Bendel

****Any previously dated CA diagram is revoked and/or invalid. Confirm this is the valid diagram for the site before beginning any construction.**


Installation/grouting inspections may be scheduled the day before, or, the day of installation until 9am by contacting the Environmental Health office at 919 496 8100. A revisit fee may apply if installation is not ready for inspection at the time requested. *Septic Operations Permits* will be issued after installation is approved, all permits conditions are met, and any outstanding fees are paid. *Well Certificate of Completion* will be issued after well head approval, all permit conditions are met, and any outstanding fees are paid.

Septic Tank _____ Pump Tank _____ Drainfield _____ Type System _____ Max Trench Depth _____

Septic Contractor True Works Septic/Pump tank dates ST 9-28-23 PT 9-17-23 Pump fee? NO (YES) pd _____

Well Contractor _____ Well Grout date: _____

* Refer to attached CCSC Septic/Well documentation #

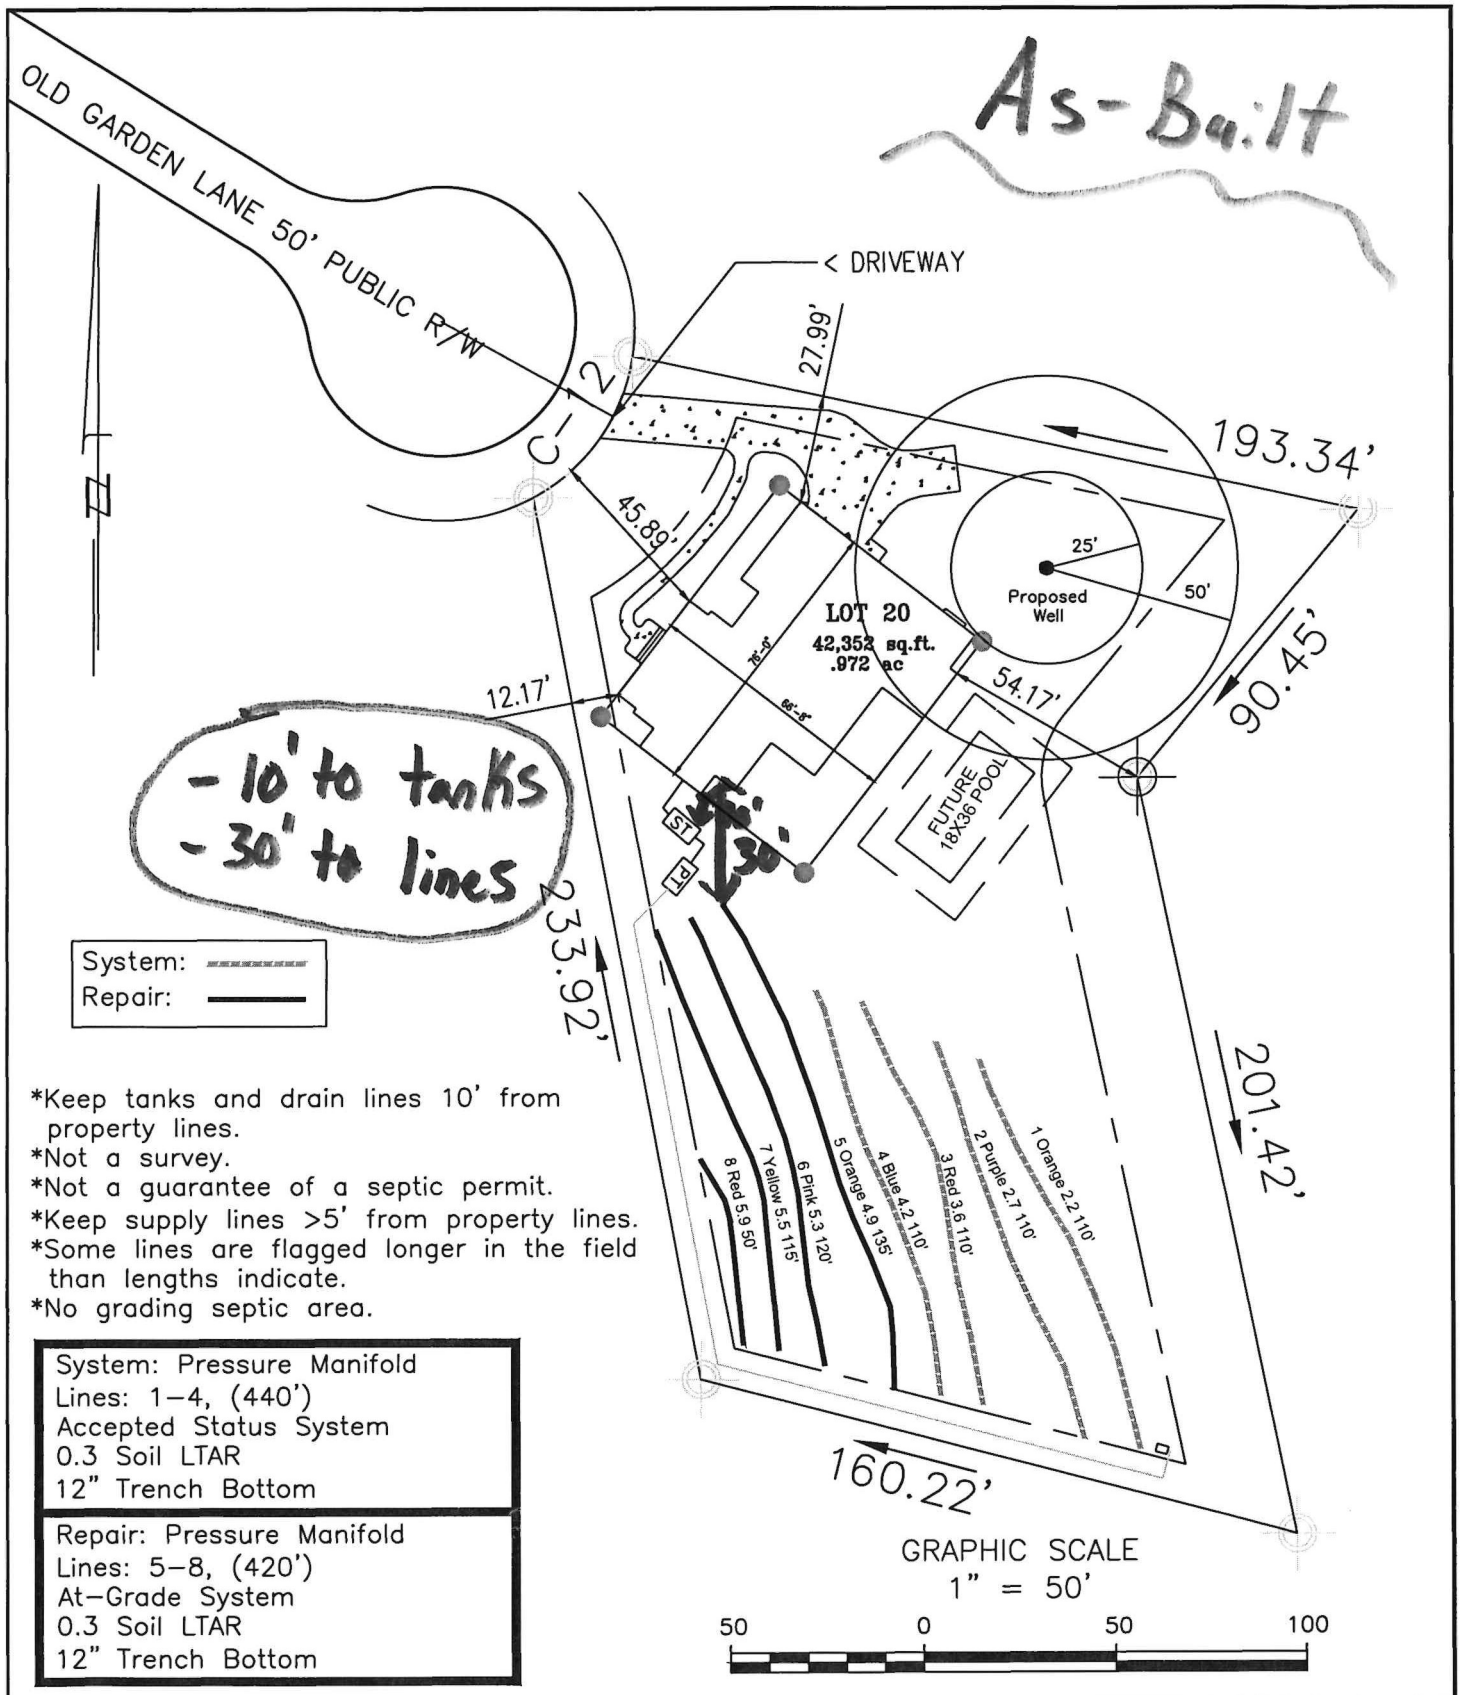

*Keep tanks and drain lines 10' from property lines.
*Not a survey.
*Not a guarantee of a septic permit.
*Keep supply lines >5' from property lines.
*Some lines are flagged longer in the field than lengths indicate.
*No grading septic area.

System: Pressure Manifold Lines: 1–4, (440') Accepted Status System 0.3 Soil LTAR 12" Trench Bottom
Repair: Pressure Manifold Lines: 5–8, (420') At–Grade System 0.3 Soil LTAR 12" Trench Bottom

CCSC
Central Carolina Soil Consulting, PLLC
1900 South Main Street, Suite 110
Wake Forest, North Carolina 27587
Phone (919)569–6704 Fax (919)569–6703

4–Bedroom Septic Layout
Lot 20, Tarborough Ridge Subdivision
Franklin County, North Carolina

Job# : 3165
Drawn By : LW
Date : 06/27/2023
Revision: