Wake

WAKE COUNTY HEALTH DEPARTMENT SEPTIC TANK LAYOUT AND PERMIT

TAX MAP NO. 614 PARCEL NO. 8(5)

PERMIT NO. B 38778
OPERATION PERMIT ☐ Marks Crk

CONTRACTOR Bill Boykin

OWNER

DATE 15 July 86

LOCATION

S. R. NO. 1003

SUBDIVISION NAME Stewarts Ridge LOT NO. 74 SECTION OR BLOCK NO.

REPAIR ☐ ORIGINAL PERMIT NO.

GARBAGE DISPOSAL UNIT YES ☐ NO ☒

HOUSE ☒ MOBILE HOME ☐ BUSINESS ☐

NO. BEDROOMS 3 LOT AREA 30,000 sq

SIZE OF TANK 1000 gal. V-Jee

NITRIFICATION LINE 1000 2 x (3 x 165') sq. ft.

DEPTH OF STONE IN LINES: 12" ☒


RISER AND BAFFLE REQUIRED ☒ PUMP REQUIRED ☐

WATER SUPPY: INDIVIDUAL ☐ PUBLIC ☒ OTHER ☐

- PERMIT VOID 36 MONTHS FROM DATE OF ISSUANCE.
- PERMIT VOID IF NOT IN COMPLIANCE WITH ZONING REGULATIONS
- PERMIT MAY BE VOIDED IF SITE ALTERATIONS MADE

LAYOUT BY G E Dietrich

* Follow contour
* * Keep shallow 12"

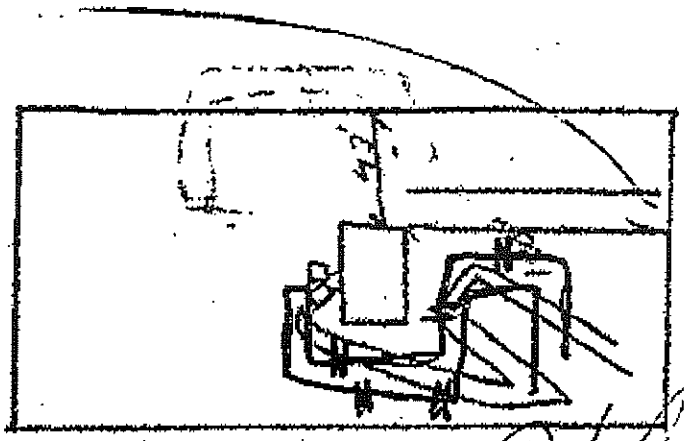

21 Jan 87
DATE

David Brantley
INSTALLED BY

APPROVED BY