Environmental Services - Water Quality
Onsite Wastewater Scan Data Entry Form

PERMIT #: B0260944 PIN #: 0789895630

OP DATE: 05/11/1983

SYSTEM USE:
- [X] House
- [ ] Mobile Home
- [ ] Business
- [ ] Other

SEWAGE TYPE:
- [X] Domestic
- [ ] Industrial

PUMP/SIPHON?:
- [ ] Yes
- [X] No

PRESSURE MANIFOLD:
- [ ] Yes
- [X] No

SYSTEM TYPE:
- [ ] I
- [X] II
- [ ] III
- [ ] IV
- [ ] V
- [ ] VI
- [ ] Other

SUB TYPE:
- [X] A
- [ ] B
- [ ] C
- [ ] D
- [ ] E
- [ ] F
- [ ] G

NBR BEDROOMS:
- [ ] 1
- [ ] 2
- [ ] 3
- [X] 4
- [ ] 5
- [ ] 6
- [ ] Other

MAINT. SCHEDULE:
- [ ] Yes
- [X] No

CERT. OPERATOR
- [ ] Yes
- [X] No

GT	ST	PT	SIZE
[ ]	[ ]		750
[ ]	[ ]	[ ]	900
[ ]	[ ]	[ ]	1,000
[ ]	[X]	[ ]	1,200
[ ]	[ ]	[ ]	1,500
[ ]	[ ]	[ ]	1,800
[ ]	[ ]	[ ]	2,100
[ ]	[ ]	[ ]	2,500
[ ]	[ ]	[ ]	3,000
[ ]	[ ]	[ ]	4,000
[ ]	[ ]	[ ]	5,000
[ ]	[ ]	[ ]	8,000
	[ ]	[ ]	10,000
[ ]	[ ]	[ ]	Other
[X]		[X]	None/NA GT or PT

DRAINFIELD SIZE(SQ. FT.)

01200

DRAIN TYPE:
- [X] Stone
- [ ] EZ Flow
- [ ] Infiltrator
- [ ] Biodiffuser
- [ ] Cultec
- [ ] Drip
- [ ] Hancor
- [ ] Large Dia. Pipe
- [ ] Multi-Pipe
- [ ] Other

MAX DEPTH (IN.):
- [ ] 12 in. or less
- [ ] 18 in. or less
- [ ] 24 in. or less
- [ ] 26 in. or less
- [ ] 28 in. or less
- [ ] 30 in. or less
- [ ] 32 in. or less
- [ ] 36 in. or less
- [X] Other

STONE DEPTH (IN.):
- [ ] 8 in. or less
- [X] 12 in. or less
- [ ] 18 in. or less
- [ ] 24 in. or less
- [ ] Other

TRENCHES:
- [X] Individual
- [ ] Bed

TRENCH WIDTH (IN.):
- [ ] 12 in. or less
- [ ] 18 in.
- [ ] 24 in.
- [X] 36 in.
- [ ] 6 ft. or less
- [ ] 9 ft. or less
- [ ] Other

WAKE COUNTY HEALTH DEPARTMENT SEPTIC TANK LAYOUT AND PERMIT

TAX MAP NO. 239 PARCEL NO. 83 **PERMIT NO. B** 26094

CONTRACTOR Lacy Buffaloe Bldg.

OWNER 11413 Old Creedmoor Rd DATE 3-8-83

LOCATION Pin 0789-89-5630

S. R. NO. 1831

SUBDIVISION NAME Blackhorse Run LOT NO. 8 SECTION OR BLOCK NO. III

REPAIR ☐ ORIGINAL PERMIT NO. _____

GARBAGE DISPOSAL UNIT YES ☐ NO ☒

HOUSE ☒ MOBILE HOME ☐ BUSINESS ☐

NO. BEDROOMS 4 LOT AREA 40,000 sq

SIZE OF TANK 1200 gal.

NITRIFICATION LINE 2(200' x 3') 1200 sq. ft.

DEPTH OF STONE IN LINES: 12" ☒ 18" ☐

RISER AND BAFFLE REQUIRED ☒ PUMP REQUIRED ☐

WATER SUPPY: INDIVIDUAL ☒ PUBLIC ☐ OTHER ☐

* PERMIT VOID 36 MONTHS FROM DATE OF ISSUANCE.
* PERMIT VOID IF NOT IN COMPLIANCE WITH ZONING REGULATIONS
* PERMIT MAY BE VOIDED IF SITE ALTERATIONS MADE

LAYOUT BY James R. Brown

Exist. Well

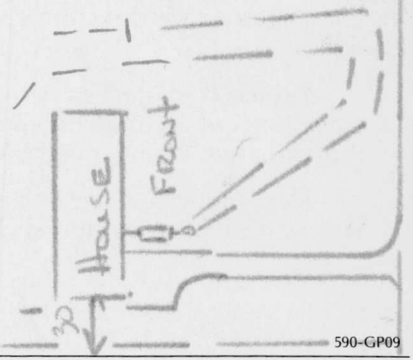

S21831

5-11-83
DATE

Custom Turf
INSTALLED BY

James R. Brown
APPROVED BY

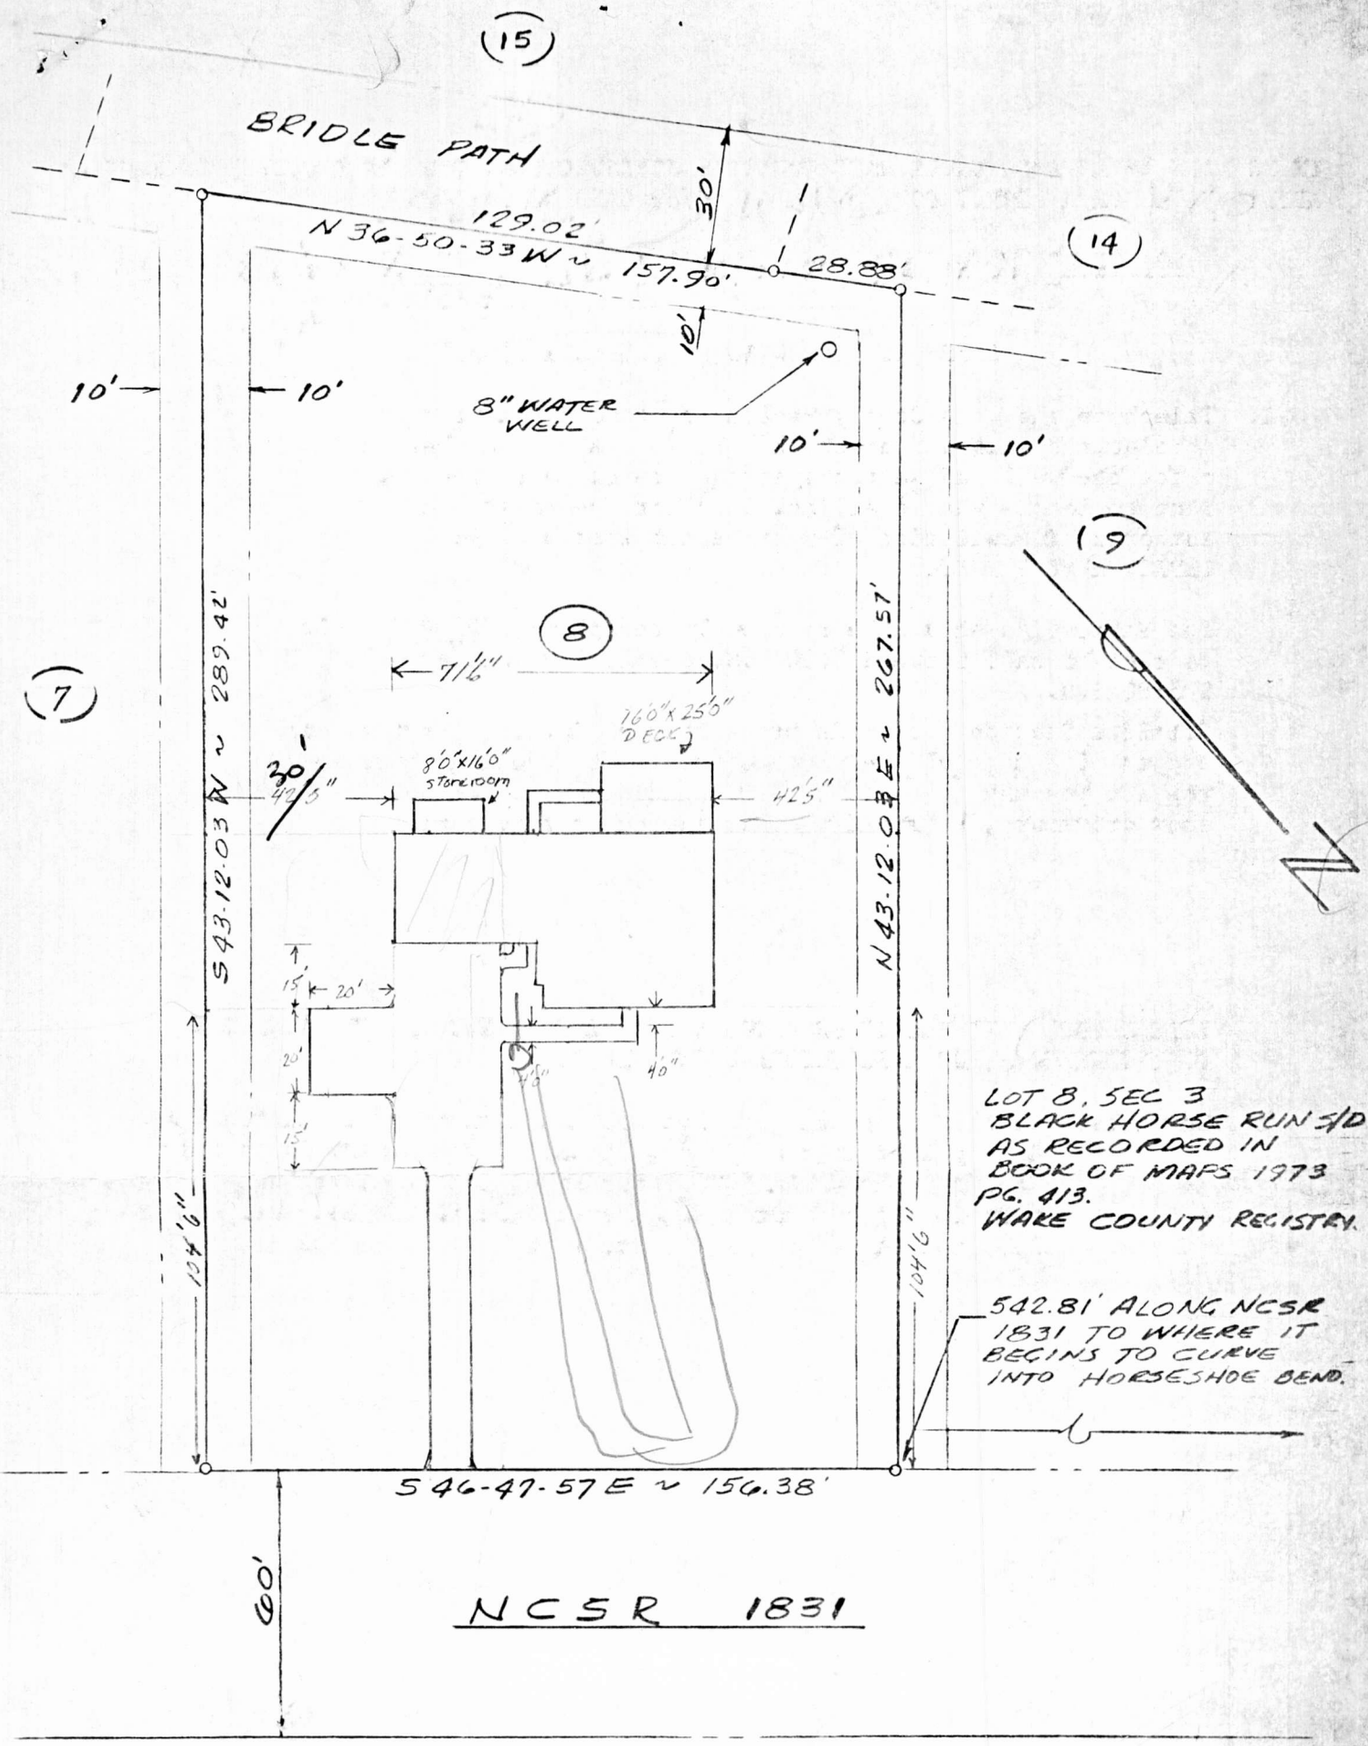

NOTE:
ALL LOT LINES HAVE A 20'
EASEMENT FOR UTILITIES, DRAINAGE
AND BURIAL OF DEBRIS.

NORTH CAROLINA
REGISTERED
SEAL
L-1272
LAND SURVEYOR
HOWARD F. CHESTNUTT

Howard F. Chestnutt
R.L.S. L-1272

PROPERTY OF
JERRY WORTH KIRK & WIFE
LAURA LENTZ KIRK
LEESVILLE TWP WAKE CO. NC

DATE 2-19-83	SURVEYED BY HOWARD CHESTNUTT RALEIGH, NORTH CAROLINA	DRAWN BY HC
SCALE 1" = 40'		FILE NO.

N51696

TAX MAP 239-83.