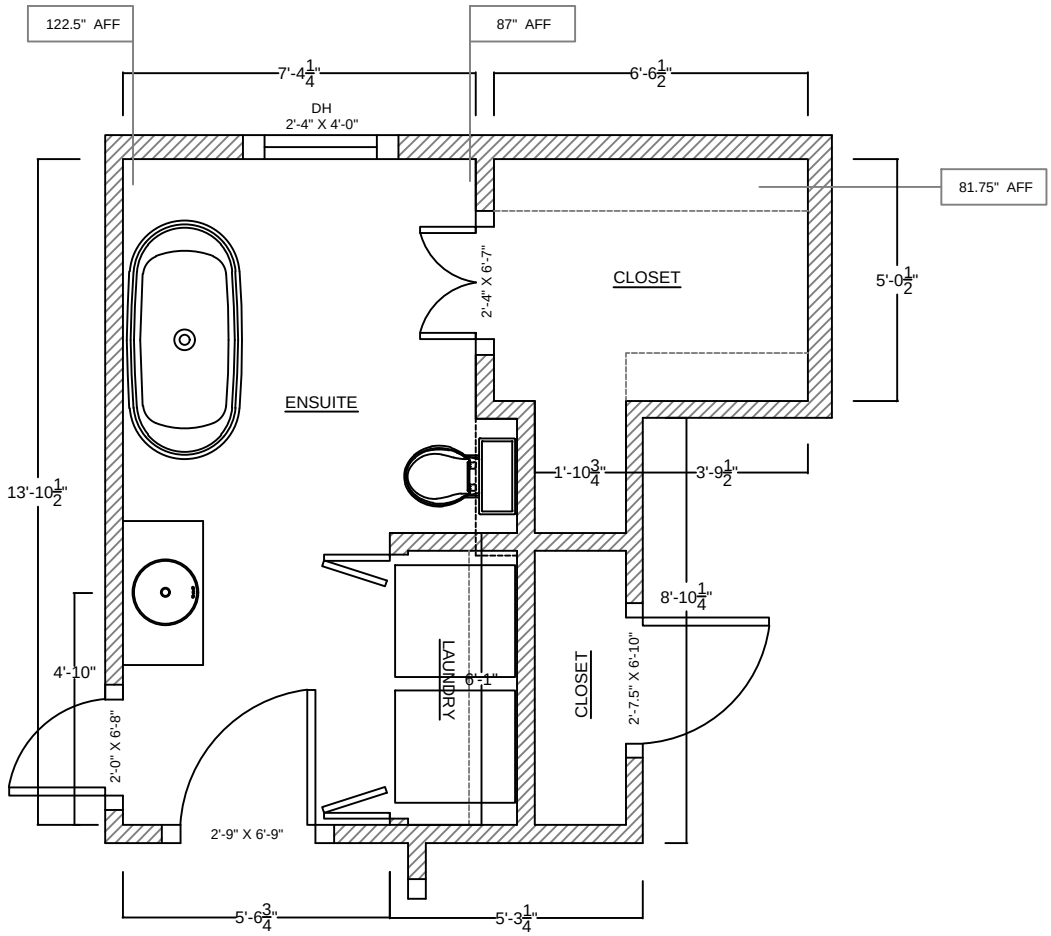


ENSUITE & CLOSET - EXISTING FLOOR PLAN

SCALE : 1 /4 " = 1' - 0"

REVISIONS


DATE :	NAME :

MICHAEL & RACHEL
319 POLK STREET. RALEIGH, NC 27604

ENSUITE & CLOSET - EXISTING FLOOR PLAN

REBECCA GRAY DESIGN, INC.
12 FRANCES STREET
CHAPEL HILL, NC

SHEET NO.
1
OF 4

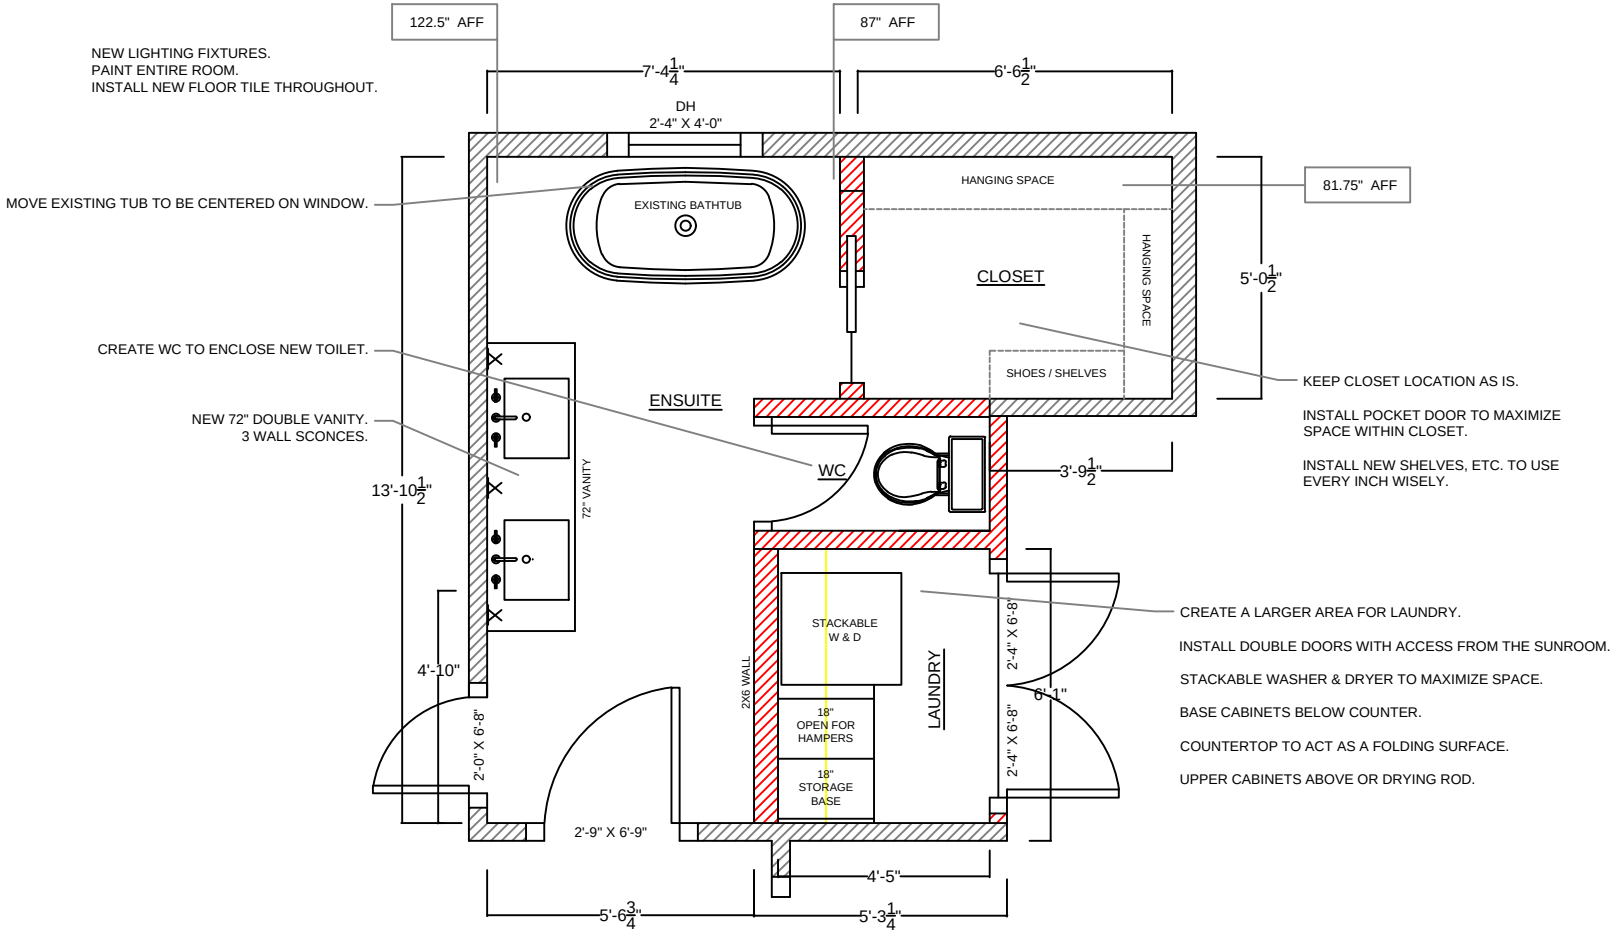

ENSUITE & CLOSET - PROPOSED REDLINE - OPTION #1

SCALE : 1 /4 " = 1' - 0"

REVISIONS


DATE :	NAME :

MICHAEL & RACHEL
319 POLK STREET. RALEIGH, NC 27604

ENSUITE & CLOSET - PROPOSED REDLINES

REBECCA GRAY DESIGN, INC.
12 FRANCES STREET
CHAPEL HILL, NC

SHEET NO.
2
OF 4

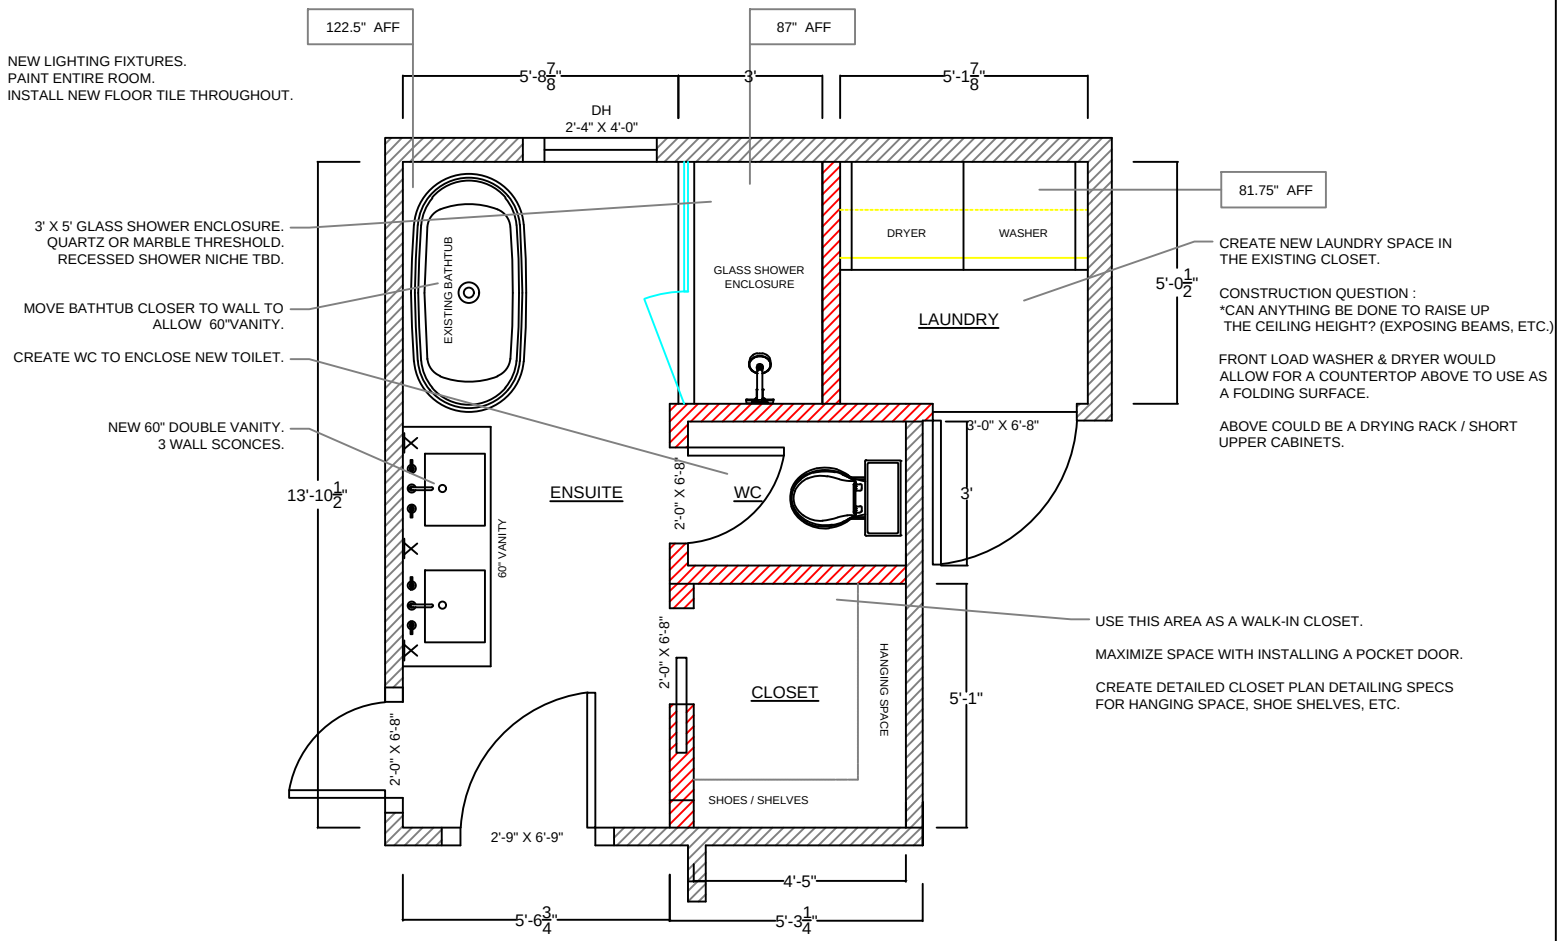

ENSUITE & CLOSET - PROPOSED REDLINE - OPTION #2

SCALE : 1 /4 " = 1' - 0"

REVISIONS

DATE :	NAME :

MICHAEL & RACHEL
319 POLK STREET. RALEIGH, NC 27604


ENSUITE & CLOSET - PROPOSED REDLINES

REBECCA GRAY DESIGN, INC.
12 FRANCES STREET
CHAPEL HILL, NC

SHEET NO.

3

OF 4

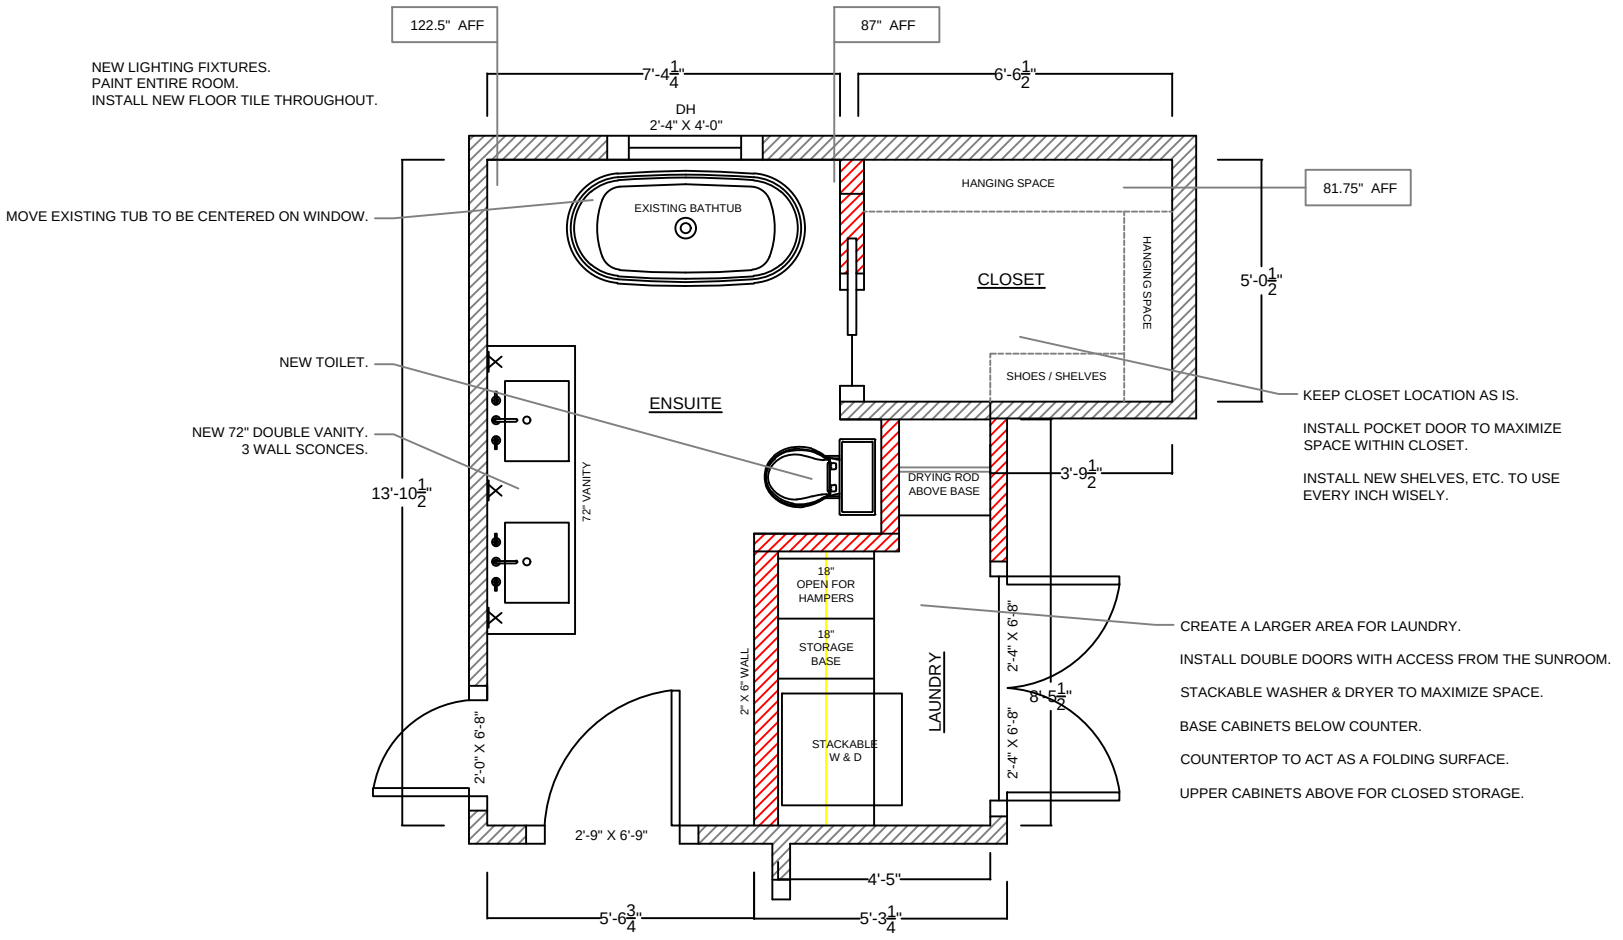

ENSUITE & CLOSET - PROPOSED REDLINE - OPTION #3

SCALE : 1 /4 " = 1' - 0"

REVISIONS

DATE :	NAME :

MICHAEL & RACHEL
319 POLK STREET. RALEIGH, NC 27604

ENSUITE & CLOSET - PROPOSED REDLINES

REBECCA GRAY DESIGN, INC.
12 FRANCES STREET
CHAPEL HILL, NC

SHEET NO.
4
OF 4