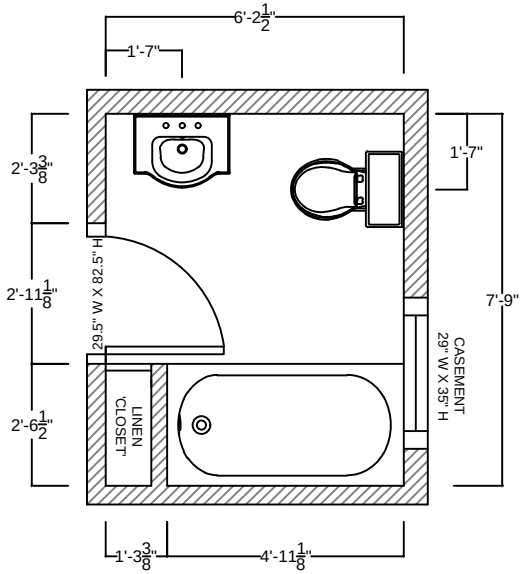


BATHROOM - EXISTING FLOOR PLAN

SCALE : 1 /4 " = 1' - 0"

90.5" AFF

REVISIONS

DATE :	NAME :


MICHAEL & RACHEL
319 POLK STREET. RALEIGH, NC 27604

BATHROOM - EXISTING FLOOR PLAN

REBECCA GRAY DESIGN, INC.
12 FRANCES STREET
CHAPEL HILL, NC

SHEET NO.
1
OF 5

NEW LIGHTING FIXTURES.
PAINT ENTIRE ROOM.
INSTALL NEW TILE THROUGHOUT - FLOOR & SHOWER WALLS.

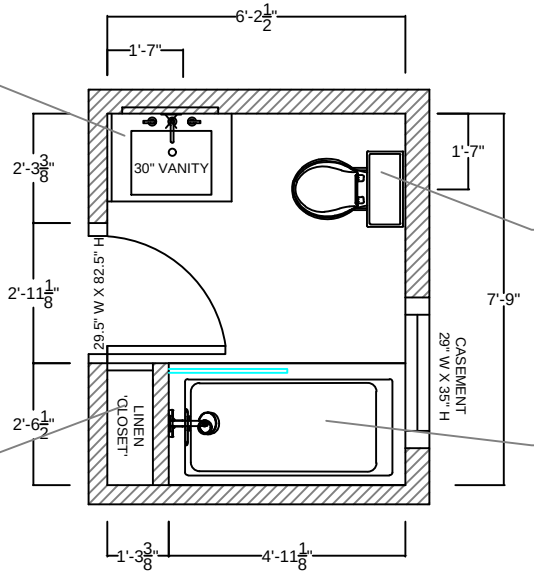

30" W. VANITY (FURNITURE BASE WITH BOTTOM CLOSED STORAGE).

PROPOSED RECESSED MEDICINE CABINET FOR ADDITIONAL STORAGE

WALL SCONCE CENTERED ABOVE SINK.

NEW TOILET.
EXISTING LOCATION.

KEEP THIS SPACE AS A CABINET.
UPDATE DOORS & HARDWARE.

NEW ALCOVE BATHTUB & PLUMBING FIXTURES.
TUB TO HAVE SQUARE ANGLES TO ALLOW MORE SPACE WHEN SHOWERING.

INSTALL GLASS SPLASH GUARD OR USE SHOWER CURTAIN.

TBD - INSTALL RECESSED SHOWER NICHE.

90.5" AFF

BATHROOM - PROPOSED REDLINE - OPTION #1

SCALE : 1 /4 " = 1' - 0"

REVISIONS

DATE :	NAME :


MICHAEL & RACHEL
319 POLK STREET. RALEIGH, NC 27604

BATHROOM - PROPOSED REDLINE

REBECCA GRAY DESIGN, INC.
12 FRANCES STREET
CHAPEL HILL, NC

SHEET NO.
2
OF 5

NEW LIGHTING FIXTURES.
PAINT ENTIRE ROOM.
INSTALL NEW TILE THROUGHOUT - FLOOR & SHOWER WALLS.

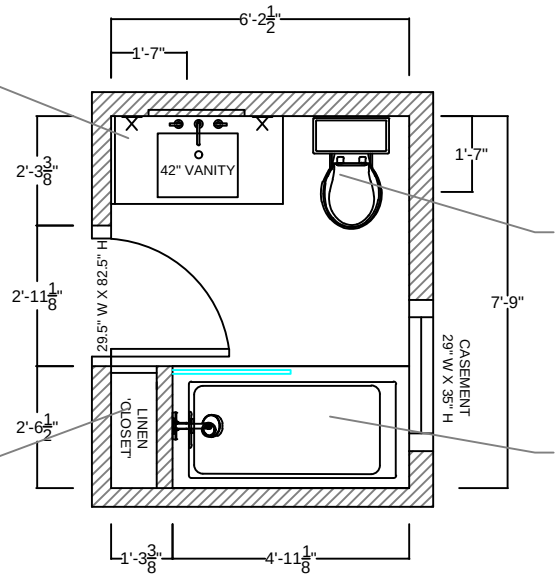

42" W. VANITY (FURNITURE BASE WITH BOTTOM CLOSED STORAGE).

PROPOSED RECESSED MEDICINE CABINET FOR ADDITIONAL STORAGE

WALL SCONCES FLANKING MIRROR.

NEW TOILET IN NEW LOCATION.

KEEP THIS SPACE AS A CABINET.
UPDATE DOORS & HARDWARE.

NEW ALCOVE BATHTUB & PLUMBING FIXTURES.
TUB TO HAVE SQUARE ANGLES TO ALLOW MORE SPACE WHEN SHOWERING.

INSTALL GLASS SPLASH GUARD OR USE SHOWER CURTAIN.

TBD - INSTALL RECESSED SHOWER NICHE.

90.5" AFF

BATHROOM - PROPOSED REDLINE - OPTION #2

SCALE : 1 /4 " = 1' - 0"

REVISIONS

DATE :	NAME :


MICHAEL & RACHEL
319 POLK STREET. RALEIGH, NC 27604

BATHROOM - PROPOSED REDLINE

REBECCA GRAY DESIGN, INC.
12 FRANCES STREET
CHAPEL HILL, NC

SHEET NO.
3
OF 5

NEW LIGHTING FIXTURES.
PAINT ENTIRE ROOM.
INSTALL NEW TILE THROUGHOUT - FLOOR & SHOWER WALLS.

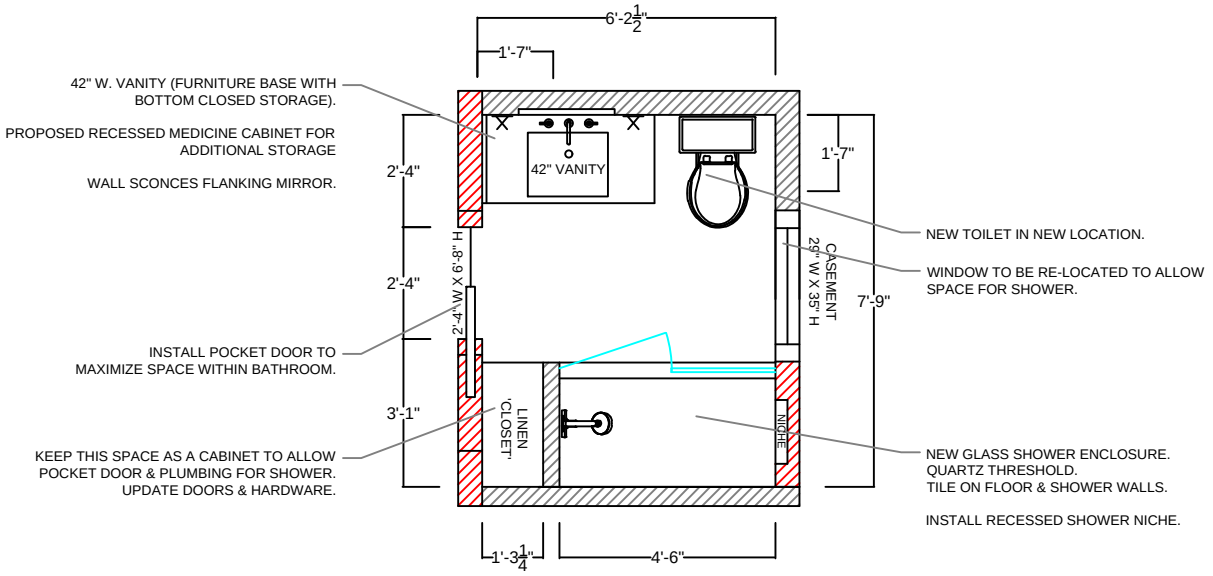

BATHROOM - PROPOSED REDLINE - OPTION #3

SCALE : 1 /4 " = 1' - 0"

REVISIONS

DATE :	NAME :


MICHAEL & RACHEL
319 POLK STREET. RALEIGH, NC 27604

BATHROOM - PROPOSED REDLINE

REBECCA GRAY DESIGN, INC.
12 FRANCES STREET
CHAPEL HILL, NC

SHEET NO.
4
OF 5

NEW LIGHTING FIXTURES.
PAINT ENTIRE ROOM.
INSTALL NEW TILE THROUGHOUT - FLOOR & SHOWER WALLS.

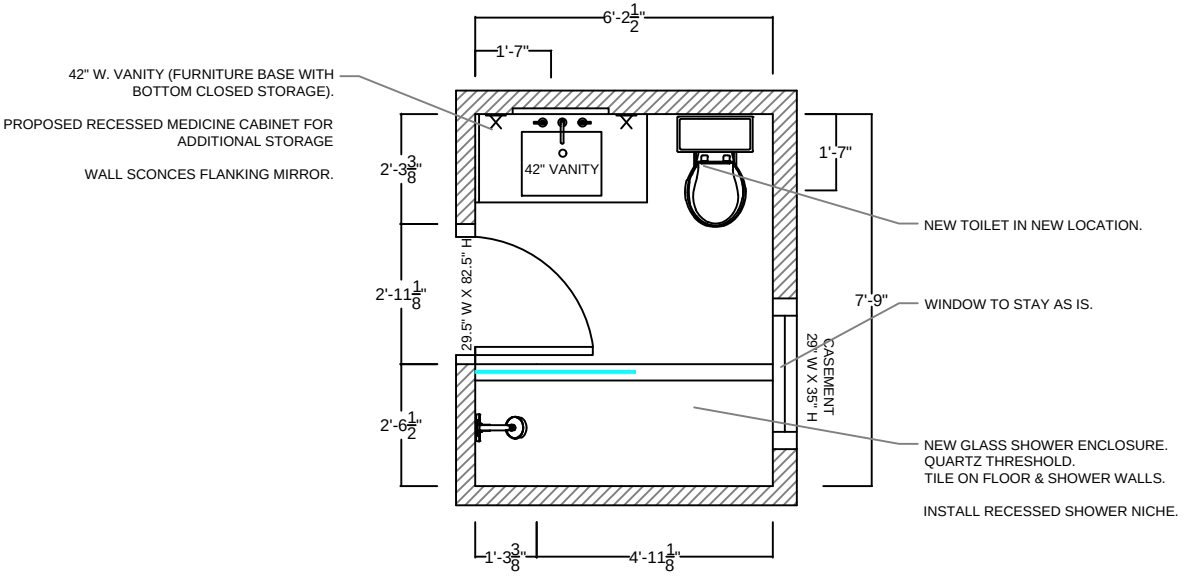

BATHROOM - PROPOSED REDLINE - OPTION #4

SCALE : 1 /4 " = 1' - 0"

REVISIONS

DATE :	NAME :

MICHAEL & RACHEL
319 POLK STREET. RALEIGH, NC 27604

BATHROOM - PROPOSED REDLINE

REBECCA GRAY DESIGN, INC.
12 FRANCES STREET
CHAPEL HILL, NC

SHEET NO.
5
OF 5