
BKCM1999PG225G1

WAKE COUNTY, NC 269
LAURA M RIDDICK
REGISTER OF DEEDS
PRESENTED & RECORDED ON
08/14/2006 AT 11:48:08

BOM 1999 PG 576

N

FIN. FLOOR ELEVS
SUITE 100 246.2'
SUITE 101 246.2'
SUITE 102 246.2'
SUITE 103 246.2'
SUITE 104 244.2'
SUITE 105 244.2'
SUITE 106 244.2'
SUITE 107 244.2'
SUITE 108 242.2'
SUITE 109 242.2'
SUITE 110 242.2'
SUITE 111 242.2'

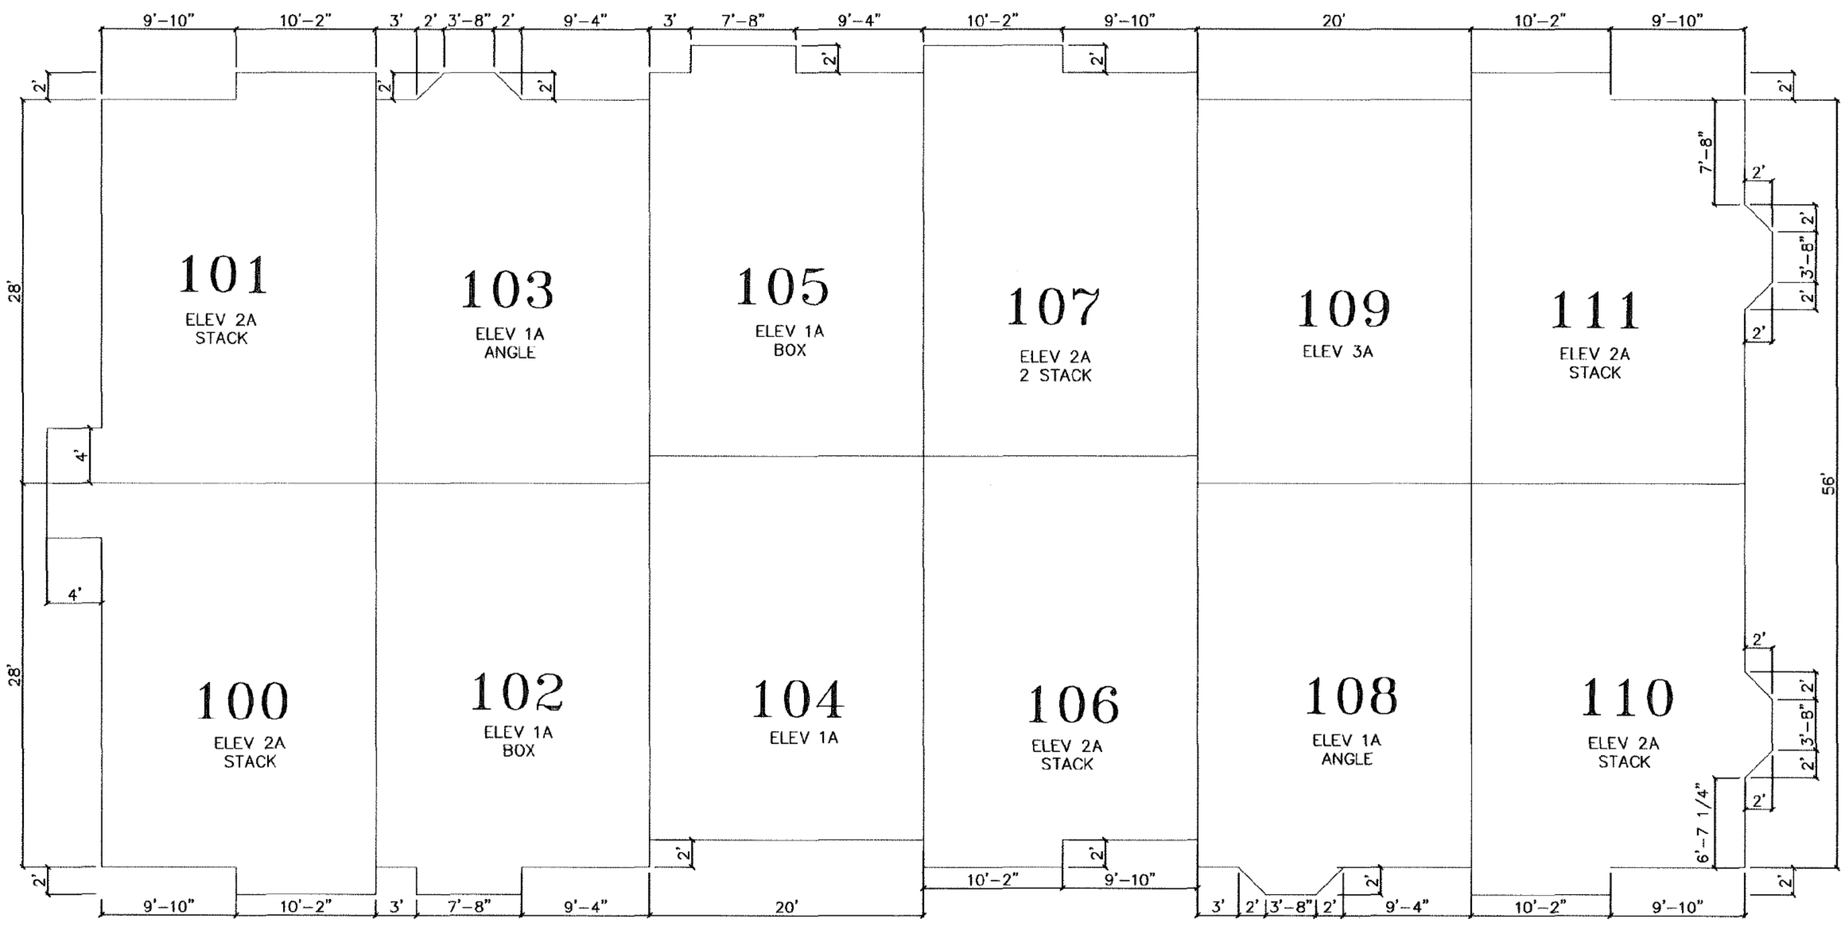

REFERENCES:
ARCHITECTURE PLANS PROVIDED BY NOTARI ASSOCIATES, 175 W. OSTEND STREET BALTIMORE MD 21230. PHONE 410-752-0330

NORTH CAROLINA PROFESSIONAL SEAL 24951 ENGINEER HAROLD A. YELLE II

2221 VALLEY EDGE ROAD BUILDING DETAIL

BUILDING FOOTPRINT
SCALE: 1/8"=1'-0"

CONDOMINIUM PLAT
PROPERTY OF
BREEZEWOOD HOMES, LLC
BREEZEWOOD CONDOMINIUMS
BUILDING 6 AS-BUILT

CITY OF RALEIGH, NEUSE TWP., WAKE CO., NC.
AUGUST 9, 2006

AYES
Aiken & Yelle Associates, PA
Professional Engineers & Land Surveyors
3755 Benson Drive
Raleigh, North Carolina 27609
Ph: (919) 877-9992 Fx: (919) 877-9979
ayes@bellsouth.net

Recorded in BK CM 1999 , Page 225G1