Environmental Services - Water Quality
Onsite Wastewater Scan Data Entry Form

PERMIT #: B0150670 PIN #: 00040526635

OP DATE: 02/05/1981

SYSTEM USE:
- [X] House
- [ ] Mobile Home
- [ ] Business
- [ ] Other

SEWAGE TYPE:
- [X] Domestic
- [ ] Industrial

PUMP/SIPHON?:
- [ ] Yes
- [X] No

PRESSURE MANIFOLD:
- [ ] Yes
- [X] No

SYSTEM TYPE:
- [ ] I
- [X] II
- [ ] III
- [ ] IV
- [ ] V
- [ ] VI
- [ ] Other

SUB TYPE:
- [X] A
- [ ] B
- [ ] C
- [ ] D
- [ ] E
- [ ] F
- [ ] G

NBR BEDROOMS:
- [ ] 1
- [ ] 2
- [X] 3
- [ ] 4
- [ ] 5
- [ ] 6
- [ ] Other

MAINT. SCHEDULE:
- [ ] Yes
- [X] No

CERT. OPERATOR
- [ ] Yes
- [X] No

GT	ST	PT	SIZE
[ ]	[ ]		750
[ ]	[ ]	[ ]	900
[ ]	[X]	[ ]	1,000
[ ]	[ ]	[ ]	1,200
[ ]	[ ]	[ ]	1,500
[ ]	[ ]	[ ]	1,800
[ ]	[ ]	[ ]	2,100
[ ]	[ ]	[ ]	2,500
[ ]	[ ]	[ ]	3,000
[ ]	[ ]	[ ]	4,000
[ ]	[ ]	[ ]	5,000
[ ]	[ ]	[ ]	8,000
	[ ]	[ ]	10,000
[ ]	[ ]	[ ]	Other
[X]		[X]	None/NA GT or PT

DRAINFIELD SIZE(SQ. FT.)

01000

DRAIN TYPE:
- [X] Stone
- [ ] EZ Flow
- [ ] Infiltrator
- [ ] Biodiffuser
- [ ] Cultec
- [ ] Drip
- [ ] Hancor
- [ ] Large Dia. Pipe
- [ ] Multi-Pipe
- [ ] Other

MAX DEPTH (IN.):
- [ ] 12 in. or less
- [ ] 18 in. or less
- [ ] 24 in. or less
- [ ] 26 in. or less
- [ ] 28 in. or less
- [ ] 30 in. or less
- [ ] 32 in. or less
- [ ] 36 in. or less
- [X] Other

STONE DEPTH (IN.):
- [ ] 8 in. or less
- [ ] 12 in. or less
- [X] 18 in. or less
- [ ] 24 in. or less
- [ ] Other

TRENCHES:
- [ ] Individual
- [X] Bed

TRENCH WIDTH (IN.):
- [ ] 12 in. or less
- [ ] 18 in.
- [ ] 24 in.
- [ ] 36 in.
- [X] 6 ft. or less
- [ ] 9 ft. or less
- [ ] Other

ON

* PERMIT VOID IF NOT IN COMPLIANCE WITH ZONING REGULATIONS

TAX MAP NO. 489
PARCEL NO. 6706

WAKE COUNTY HEALTH DEPARTMENT
SEPTIC TANK LAYOUT AND PERMIT

PERMIT NO. B 15767

OWNER OR CONTRACTOR TRI-CITY Builders DATE 6-25-79

LOCATION 1412 Princess Anne Dr S. R. NO.

SUBDIVISION NAME Medfield Estates LOT NO. 176 SECTION OR BLOCK NO.

GARBAGE DISPOSAL UNIT YES ☐ NO ☑

HOUSE ☑ MOBILE HOME ☐ BUSINESS ☐

NO. BEDROOMS 3 LOT AREA 35+ 20+

SIZE OF TANK 1000 gal.

NITRIFICATION LINE 6'X167' 1002 sq. ft.

DEPTH OF STONE IN LINES: 12" ☐ 18" ☑

WATER SUPPLY: INDIVIDUAL ☐ PUBLIC ☑

* PERMIT VOID 12 MONTHS FROM DATE OF ISSUANCE.

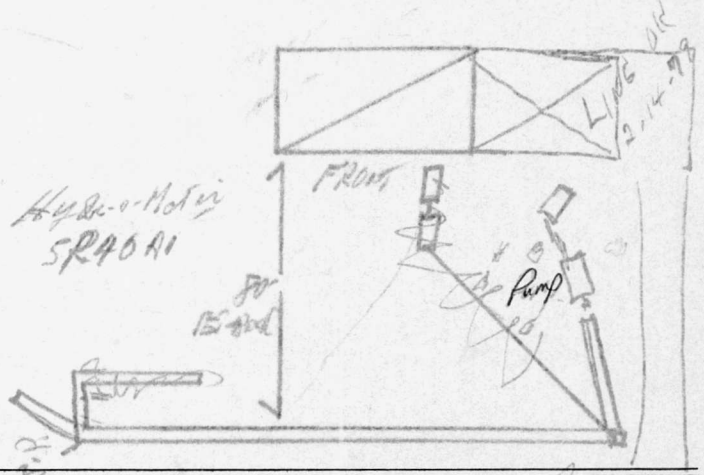

LAYOUT BY M Franks

2-5-79
DATE

Ed Barr
INSTALLED BY

M Franks
APPROVED BY