Environmental Services - Water Quality
Onsite Wastewater Scan Data Entry Form

PERMIT #: C01648 9 PIN #: 1617382038

OP DATE: 05/11/1993

SYSTEM USE:
- [x] House
- [ ] Mobile Home
- [ ] Business
- [ ] Other

SEWAGE TYPE:
- [x] Domestic
- [ ] Industrial

PUMP/SIPHON?:
- [ ] Yes
- [x] No

PRESSURE MANIFOLD:
- [ ] Yes
- [x] No

SYSTEM TYPE:
- [ ] I
- [x] II
- [ ] III
- [ ] IV
- [ ] V
- [ ] VI
- [ ] Other

SUB TYPE:
- [x] A
- [ ] B
- [ ] C
- [ ] D
- [ ] E
- [ ] F
- [ ] G

NBR BEDROOMS:
- [ ] 1
- [ ] 2
- [x] 3
- [ ] 4
- [ ] 5
- [ ] 6
- [ ] Other

MAINT. SCHEDULE:
- [ ] Yes
- [x] No

CERT. OPERATOR
- [ ] Yes
- [x] No

| GT | ST | PT | SIZE |
|---|---|---|---|
| ☐ | ☐ | | 750 |
| ☐ | ☐ | ☐ | 900 |
| ☐ | ☒ | ☐ | 1,000 |
| ☐ | ☐ | ☐ | 1,200 |
| ☐ | ☐ | ☐ | 1,500 |
| ☐ | ☐ | ☐ | 1,800 |
| ☐ | ☐ | ☐ | 2,100 |
| ☐ | ☐ | ☐ | 2,500 |
| ☐ | ☐ | ☐ | 3,000 |
| ☐ | ☐ | ☐ | 4,000 |
| ☐ | ☐ | ☐ | 5,000 |
| ☐ | ☐ | ☐ | 8,000 |
| | ☐ | ☐ | 10,000 |
| ☐ | ☐ | ☐ | Other |
| ☒ | | ☒ | None/NA GT or PT |

DRAINFIELD SIZE(SQ. FT.)

00750

DRAIN TYPE:
- [x] Stone
- [ ] EZ Flow
- [ ] Infiltrator
- [ ] Biodiffuser
- [ ] Cultec
- [ ] Drip
- [ ] Hancor
- [ ] Large Dia. Pipe
- [ ] Multi-Pipe
- [ ] Other

MAX DEPTH (IN.):
- [ ] 12 in. or less
- [ ] 18 in. or less
- [ ] 24 in. or less
- [ ] 26 in. or less
- [ ] 28 in. or less
- [ ] 30 in. or less
- [ ] 32 in. or less
- [x] 36 in. or less
- [ ] Other

STONE DEPTH (IN.):
- [ ] 8 in. or less
- [x] 12 in. or less
- [ ] 18 in. or less
- [ ] 24 in. or less
- [ ] Other

TRENCHES:
- [x] Individual
- [ ] Bed

TRENCH WIDTH (IN.):
- [ ] 12 in. or less
- [ ] 18 in.
- [ ] 24 in.
- [x] 36 in.
- [ ] 6 ft. or less
- [ ] 9 ft. or less
- [ ] Other

B.W 12/3/14

230

# WAKE COUNTY HEALTH DEPARTMENT WELL AND SEWAGE SITE, LOCATION PERMIT

*ALL PERMITS VOID 60 MONTHS FROM DATE OF ISSUANCE*

Tax Map No. 827 Parcel No. 44

Improvement Permit
Well Permit No. C 16489
Operation Permit [ ]

Zoning _____ Township Panther Branch.


Owner/Contractor: Steve Harrell Date: March 11, 1993

Location/Address: 6013 BRACK PENNY RD. & 505 TR JORDON TL BRACK PENNY TL S.R. # 2732

Subdivision Name: HUNT FARMS Lot No. 1 Section or Block No. _____

Tax Map No. 827 Parcel No. 44

**Preliminary Layout**

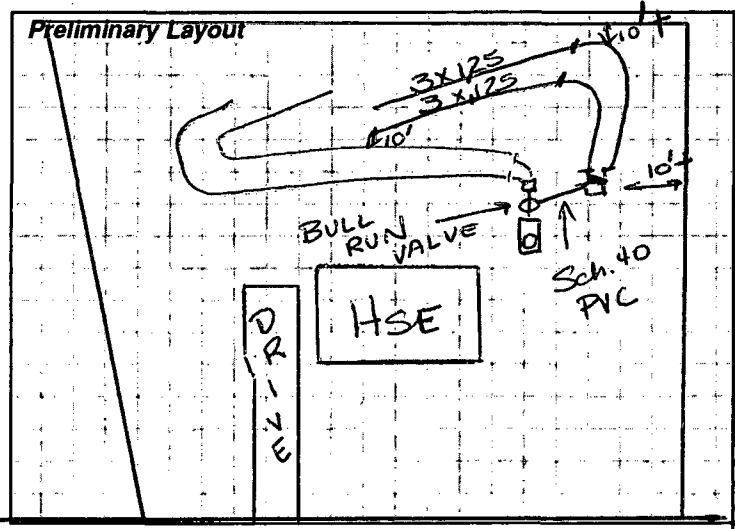


**Final Layout**

#2 NEW LINES
#1 OLD LINES

**Sewage System Specifications**

Repair [✓] Original Permit No. _____

Garbage Disposal Unit Yes [ ] No [✓]

House [✓] Mobile Home [ ] Business [ ]

No. of Bedrooms 3 Lot Area _____

Size of Tank 1000 gal.

Comments: ~~SFD~~

Nitrification Line 2X(3'X125')=750 sq. ft.

Depth of Stone: 12" [✓] Max Depth of Trenches: 36 in.

Riser and Baffle Required [ ] Pump Required [ ]

☛ Permit void if not in compliance with zoning regulations

☛ Permits may be voided if site is altered or intended use changed

Layout by: Andre C. Pierce, R.S.

Date: 5-11-93 Installed By: Don Wilson Approved By: W. Paul Brown Jr.

**Well System**

Individual [ ] Semi-Public [ ] Public [✓]
New [ ] Replacement [ ] Repair [ ]
Fee Paid: Yes [ ] No [ ]

| *Construction Compliance* | Yes | No |
|---|---|---|
| Site Approved | [ ] | [ ] |
| Well Head Approved | [ ] | [ ] |
| Grouting Approved | [ ] | [ ] |

_____ _____
*Date Inspected* *Sanitarian*

**Bacteriological Results**

Initial Sample: _____ Date: _____
* Re-Sample #1 _____ Date: _____
* Re-Sample #2 _____ Date: _____
* Re-chlorination as required [ ] Yes [ ] No
* *Fees for all resamples*

All checks payable to: **Wake County Health Department**

| *Final Inspection* | Yes | No |
|---|---|---|
| Required Slab | [ ] | [ ] |
| Chlorinated | [ ] | [ ] |
| Required Certificate | [ ] | [ ] |
| Variance (Explain) | [ ] | [ ] |
| WCHD I.D. Affixed | [ ] | [ ] |
| Sample Collected | [ ] | [ ] |

Comments: _____

Well Installed By: _____

_____ _____
*Date System Finalized* *Sanitarian*

This report is based in part on information provided by the homeowner or his/her representative in the application submitted for this permit. The sanitarian is not responsible for false or misleading information contained in the application. The sanitarian is also not responsible for concealed conditions on the property or for statements in this report that may have resulted from false or misleading statements provided to him in the application. Neither Wake County nor the sanitarian warrants that the septic tank system will continue to function satisfactorily in the future or that the water supply will remain potable.

**COPY TO HEALTH DEPARTMENT**