3-2803pd

PERMIT IS SUBJECT TO REVOCATION IF SITE PLANS OR INTENDED USE CHANGE

WARREN COUNTY HEALTH DEPARTMENT

( ) Suitable
(✓) Provisionally Suitable
( ) Upgrading of existing system
( ) Repair of existing system
( ) Pump system

This Permit replaces #13984

ENVIRONMENTAL HEALTH DIVISION

720 WEST RIDGEWAY STREET
WARRENTON, NC 27589
PHONE (252) 257-1538
FAX (252) 257-4460

Permit No. 4186
Fee 150.00
Paid 7/22/02

IMPROVEMENT PERMIT

Owner Jesse + Janis Jennings Phone #: 610-874-5852
Address 1257 Kerlin ST. Chester, PA 19013
Subdivision Name Fishers Ferry Estates Lot # 229+228 Block # _____ Section # _____
Directions to lot (RPR#) ON SUNSET

Application Date ~~3/17/03~~ 8/8/02

— Improvement permit with scale drawing on plat is valid without expiration

IMPROVEMENT PERMIT APPROVAL

Date 3/17/03 Fred D Lee
Environmental Health Specialist

— **Improvement permit with site plan is valid for 60 months**

CONSTRUCTION AUTHORIZATION

Original Deed Date _____ Land Use House # of bedrooms 3 # of people 6
Water Supply private well Distance from well and/or water lines 50'
Well installed at time of inspection ( ) Yes (✓) No Dist. from septic system _____
Design daily flow of sewage 360 gals. Kitchen garbage grinder NO Other _____
Septic tank capacity 1000 gals. Nitrification field 300 Sq. Ft. of 10" CDP
Maximum trench depth 48 inches Artificial drainage required NO
(if yes, see attached plan)

CONSTRUCTION AUTHORIZATION APPROVAL

Date 3/17/03 Fred D Lee
Environmental Health Specialist

***CONSTRUCTION AUTHORIZATION IS VALID FOR 5 YEARS FROM DATE OF ISSUE**

Saprolite System
See ATTACHED

COMMENTS: (1) RUN TRENCHES 3' WIDE AND AT LEAST 9' ON CENTERS (2) RUN LINES CONTOUR TO SLOPE 3) RUN LINES OF EQUAL LENGTH (4) EFFLUENT FILTER REQUIRED 5) TANK MARKERS/RISERS NECESSARY 6) IF TANK LOCATION IS SPECIFIED ON SITE PLAN SEPTIC PERMIT-HOUSE, MH OR STRUCTURE TO BE PLUMBED ACCORDINGLY. 7) INSTALL INITIAL SYSTEM IN DESIGNATED AREA

THE SEPTIC TANK SYSTEM AND OTHER IMPROVEMENTS THAT ARE MADE SHALL BE INSTALLED AS SHOWN IN THE SITE SKETCH PLAN. NO CHANGES SHALL BE MADE WITHOUT APPROVAL FROM THE HEALTH DEPARTMENT.

ANY VARIATIONS FROM THE CONDITIONS AND REQUIREMENTS PREVIOUSLY DESCRIBED WILL VOID THE PERMIT. THIS IS AN OFFICIAL DOCUMENT. PLEASE RETAIN WITH OTHER VALUABLE PAPERS.

***DO NOT LANDSCAPE LOT BEFORE HEALTH DEPARTMENT APPROVAL. DO NOT LOCATE DRIVEWAYS, PARKING AREAS, OR OTHER BUILDINGS OVER SEPTIC TANK SYSTEM. LANDSCAPE AREA OVER SEPTIC TANK SYSTEM TO PREVENT PONDING OF WATER. SEED WITH GRASS TO HELP PREVENT SOIL EROSION AND TO IMPROVE EVAPOTRANSPIRATION.**

3-100's System Installed As Designed

OPERATION PERMIT APPROVAL

DATE 3/26/03 Fred D Lee
ENVIRONMENTAL HEALTH SPECIALIST


CONTRACTOR: Bryant + Cassiter
B+C Tank 1/13/03

OPERATION PERMIT

NOTE: THE SEPTIC TANK, AND NITRIFICATION FIELD MUST BE INSPECTED BY A REPRESENTATIVE OF THE HEALTH DEPARTMENT BEFORE THEY ARE COVERED.

THE SIGNING OF THIS CERTIFICATE SHALL INDICATE THAT THIS SYSTEM HAS BEEN INSTALLED IN COMPLIANCE WITH THE CURRENT LAW & RULES FOR SANITARY SEWAGE COLLECTION, TREATMENT AND DISPOSAL SET FORTH IN ARTICLE 11 OF GENERAL STATUTE 130A. SECTION. 1900 OF THE NORTH CAROLINA ADMINISTRATIVE CODE TITLE 10, HEALTH SERVICES. ENVIRONMENTAL HEALTH SUBCHAPTER 10A SANITATION AND SHALL IN NO WAY BE A GUARANTEE THAT THE SEPTIC TANK SYSTEM WILL FUNCTION SATISFACTORILY FOR ANY GIVEN PERIOD OF TIME.

Install 300' of
Large Diameter Pipe
on 7.5 ft centers
as shown on drawing.
Install at depth of
4 feet below surface
in conductor in 1 ft trench
width.
Trenches should be
level.

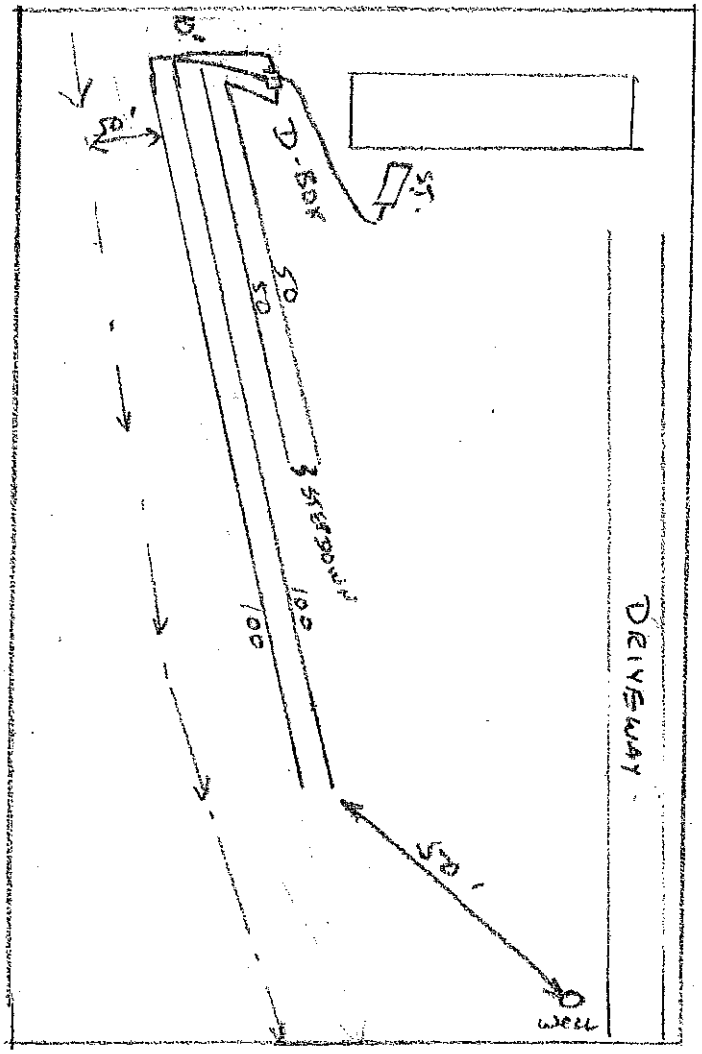

Property line setback = 10 ft
foundation setback = 5 ft
well setback = 50 ft