Environmental Services - Water Quality
Onsite Wastewater Scan Data Entry Form

PERMIT #: B 0 1 0 7 8 7 PIN #: 1 8 1 0 6 0 8 2 9 2

OP DATE: 0 7 1 0 6 1 1 9 7 7

SYSTEM USE:
- [x] House
- [ ] Mobile Home
- [ ] Business
- [ ] Other

SEWAGE TYPE:
- [x] Domestic
- [ ] Industrial

PUMP/SIPHON?:
- [ ] Yes
- [x] No

PRESSURE MANIFOLD:
- [ ] Yes
- [x] No

SYSTEM TYPE:
- [ ] I
- [x] II
- [ ] III
- [ ] IV
- [ ] V
- [ ] VI
- [ ] Other

SUB TYPE:
- [x] A
- [ ] B
- [ ] C
- [ ] D
- [ ] E
- [ ] F
- [ ] G

NBR BEDROOMS:
- [ ] 1
- [ ] 2
- [ ] 3
- [x] 4
- [ ] 5
- [ ] 6
- [ ] Other

MAINT. SCHEDULE:
- [ ] Yes
- [x] No

CERT. OPERATOR
- [ ] Yes
- [x] No

GT	ST	PT	SIZE
☐	☐		750
☐	☐	☐	900
☐	☐	☐	1,000
☐	☒	☐	1,200
☐	☐	☐	1,500
☐	☐	☐	1,800
☐	☐	☐	2,100
☐	☐	☐	2,500
☐	☐	☐	3,000
☐	☐	☐	4,000
☐	☐	☐	5,000
☐	☐	☐	8,000
	☐	☐	10,000
☐	☐	☐	Other
☒		☒	None/NA GT or PT

DRAINFIELD SIZE(SQ. FT.)

0 1 2 0 0

DRAIN TYPE:
- [x] Stone
- [ ] EZ Flow
- [ ] Infiltrator
- [ ] Biodiffuser
- [ ] Cultec
- [ ] Drip
- [ ] Hancor
- [ ] Large Dia. Pipe
- [ ] Multi-Pipe
- [ ] Other

MAX DEPTH (IN.):
- [ ] 12 in. or less
- [ ] 18 in. or less
- [ ] 24 in. or less
- [ ] 26 in. or less
- [ ] 28 in. or less
- [ ] 30 in. or less
- [ ] 32 in. or less
- [ ] 36 in. or less
- [x] Other

STONE DEPTH (IN.):
- [ ] 8 in. or less
- [ ] 12 in. or less
- [x] 18 in. or less
- [ ] 24 in. or less
- [ ] Other

TRENCHES:
- [ ] Individual
- [x] Bed

TRENCH WIDTH (IN.):
- [ ] 12 in. or less
- [ ] 18 in.
- [ ] 24 in.
- [ ] 36 in.
- [x] 6 ft. or less
- [ ] 9 ft. or less
- [ ] Other

* PERMIT VOID IF NOT IN COMPLIANCE WITH ZONING REGULATIONS

TAX MAP NO. 228
PARCEL NO. 104

WAKE COUNTY HEALTH DEPARTMENT
SEPTIC TANK LAYOUT AND PERMIT

PERMIT NO. B 10787

OWNER OR CONTRACTOR James Knox DATE 6-13-77


S. R. NO. 2002

SUBDIVISION NAME Ravenwood LOT NO. 04 SECTION OR BLOCK NO.

GARBAGE DISPOSAL UNIT YES ☐ NO ☒

HOUSE ☒ MOBILE HOME ☐ BUSINESS ☐

NO. BEDROOMS 4 LOT AREA 40,000 ^{2}Ft


SIZE OF TANK 1200 gal.

NITRIFICATION LINE 1200 sq. ft.

DEPTH OF STONE IN LINES: 12" ☐ 18" ☐

WATER SUPPLY: INDIVIDUAL ☐ PUBLIC ☐

* PERMIT VOID 12 MONTHS FROM DATE OF ISSUANCE.

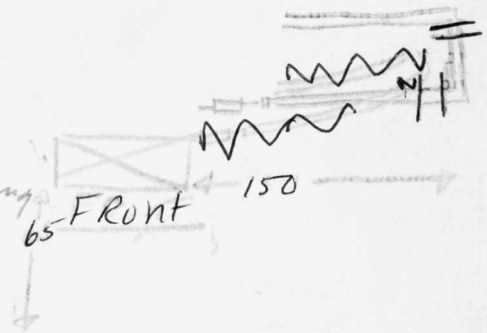

LAYOUT BY A. Ward R.S.

7-6-77 DATE

Joe Montague INSTALLED BY

A. Ward APPROVED BY