8-5-02cpl

PERMIT IS SUBJECT TO REVOCATION IF SITE PLANS OR INTENDED USE CHANGE

WARREN COUNTY HEALTH DEPARTMENT

( ) Suitable
(✓) Provisionally Suitable
( ) Upgrading of existing system
( ) Repair of existing system
( ) Pump system

1130 - 2:00

ENVIRONMENTAL HEALTH DIVISION

720 WEST RIDGEWAY STREET
WARRENTON, NC 27589
PHONE (252) 257-1538
FAX (252) 257-4460

Permit No. 3946
Fee #150.00
Paid 6-21-02

IMPROVEMENT PERMIT

Owner M. F. DARDEN Phone #: 919-693-6232
Address 102 COURT ST. OXFORD NC 27565
Subdivision Name SUNSET RIDGE Lot # 24 Block # _____ Section # _____
Directions to lot (RPR#) HWY 1001 TR SR# 1100 — 1 MILE ON LEFT TL
FOLLOW STRAIGHT BACK TO REAR

Application Date 6-25-02

— Improvement permit with scale drawing on plat is valid without expiration

✓ Improvement permit with site plan is valid for 60 months

IMPROVEMENT PERMIT APPROVAL

Date 7-3-02 Marshall Brothers RS
Environmental Health Specialist

CONSTRUCTION AUTHORIZATION

Original Deed Date _____ Land Use MOBILE HOME # of bedrooms 3 # of people 4
Water Supply COUNTY WATER Distance from well and/or water lines 100'/10'
Well installed at time of inspection ( ) Yes ( ) No Dist. from septic system _____
Design daily flow of sewage 360 gals. Kitchen garbage grinder NO Other —
Septic tank capacity 1000 gals. → EHS #789 Nitrification field 900 Sq. Ft.
Maximum trench depth 24-30 inches 6-3-02 DATE ON TANK Artificial drainage required NO
(if yes, see attached plan)

CONSTRUCTION AUTHORIZATION APPROVAL

Date 7-3-02 Marshall Brothers RS
Environmental Health Specialist

***CONSTRUCTION AUTHORIZATION IS VALID FOR 5 YEARS FROM DATE OF ISSUE**

KEEP MINIMUM 10' OFF PROPERTY LINES
" " 5' " FOUNDATION
" " 50' " ANY WELL

COMMENTS: (1) RUN TRENCHES 3' WIDE AND AT LEAST 9' ON CENTERS (2) RUN LINES CONTOUR TO SLOPE (3) RUN LINES OF EQUAL LENGTH (4) EFFLUENT FILTER REQUIRED
TANK MARKERS

THE SEPTIC TANK SYSTEM AND OTHER IMPROVEMENTS THAT ARE MADE SHALL BE INSTALLED AS SHOWN IN THE SITE SKETCH PLAN. NO CHANGES SHALL BE MADE WITHOUT APPROVAL FROM THE HEALTH DEPARTMENT.

ANY VARIATIONS FROM THE CONDITIONS AND REQUIREMENTS PREVIOUSLY DESCRIBED WILL VOID THE PERMIT. THIS IS AN OFFICIAL DOCUMENT. PLEASE RETAIN WITH OTHER VALUABLE PAPERS.

***DO NOT LANDSCAPE LOT BEFORE HEALTH DEPARTMENT APPROVAL. DO NOT LOCATE DRIVEWAYS, PARKING AREAS, OR OTHER BUILDINGS OVER SEPTIC TANK SYSTEM. LANDSCAPE AREA OVER SEPTIC TANK SYSTEM TO PREVENT PONDING OF WATER. SEED WITH GRASS TO HELP PREVENT SOIL EROSION AND TO IMPROVE EVAPOTRANSPIRATION.**

OPERATION PERMIT

OPERATION PERMIT APPROVAL

DATE 7-29-02 Marshall Brothers
ENVIRONMENTAL HEALTH SPECIALIST

CONTRACTOR: COLE'S BACKHOE

NOTE: THE SEPTIC TANK, AND NITRIFICATION FIELD MUST BE INSPECTED BY A REPRESENTATIVE OF THE HEALTH DEPARTMENT BEFORE THEY ARE COVERED.

THE SIGNING OF THIS CERTIFICATE SHALL INDICATE THAT THIS SYSTEM HAS BEEN INSTALLED IN COMPLIANCE WITH THE CURRENT LAW & RULES FOR SANITARY SEWAGE COLLECTION, TREATMENT AND DISPOSAL SET FORTH IN ARTICLE 11 OF GENERAL STATUTE 130A. SECTION. 1900 OF THE NORTH CAROLINA ADMINISTRATIVE CODE TITLE 10, HEALTH SERVICES. ENVIRONMENTAL HEALTH SUBCHAPTER 10A SANITATION AND SHALL IN NO WAY BE A GUARANTEE THAT THE SEPTIC TANK SYSTEM WILL FUNCTION SATISFACTORILY FOR ANY GIVEN PERIOD OF TIME.

WHITE - OWNER'S COPY · YELLOW - HEALTH DEPT. COPY · PINK - INSPECTION DEPT. COPY

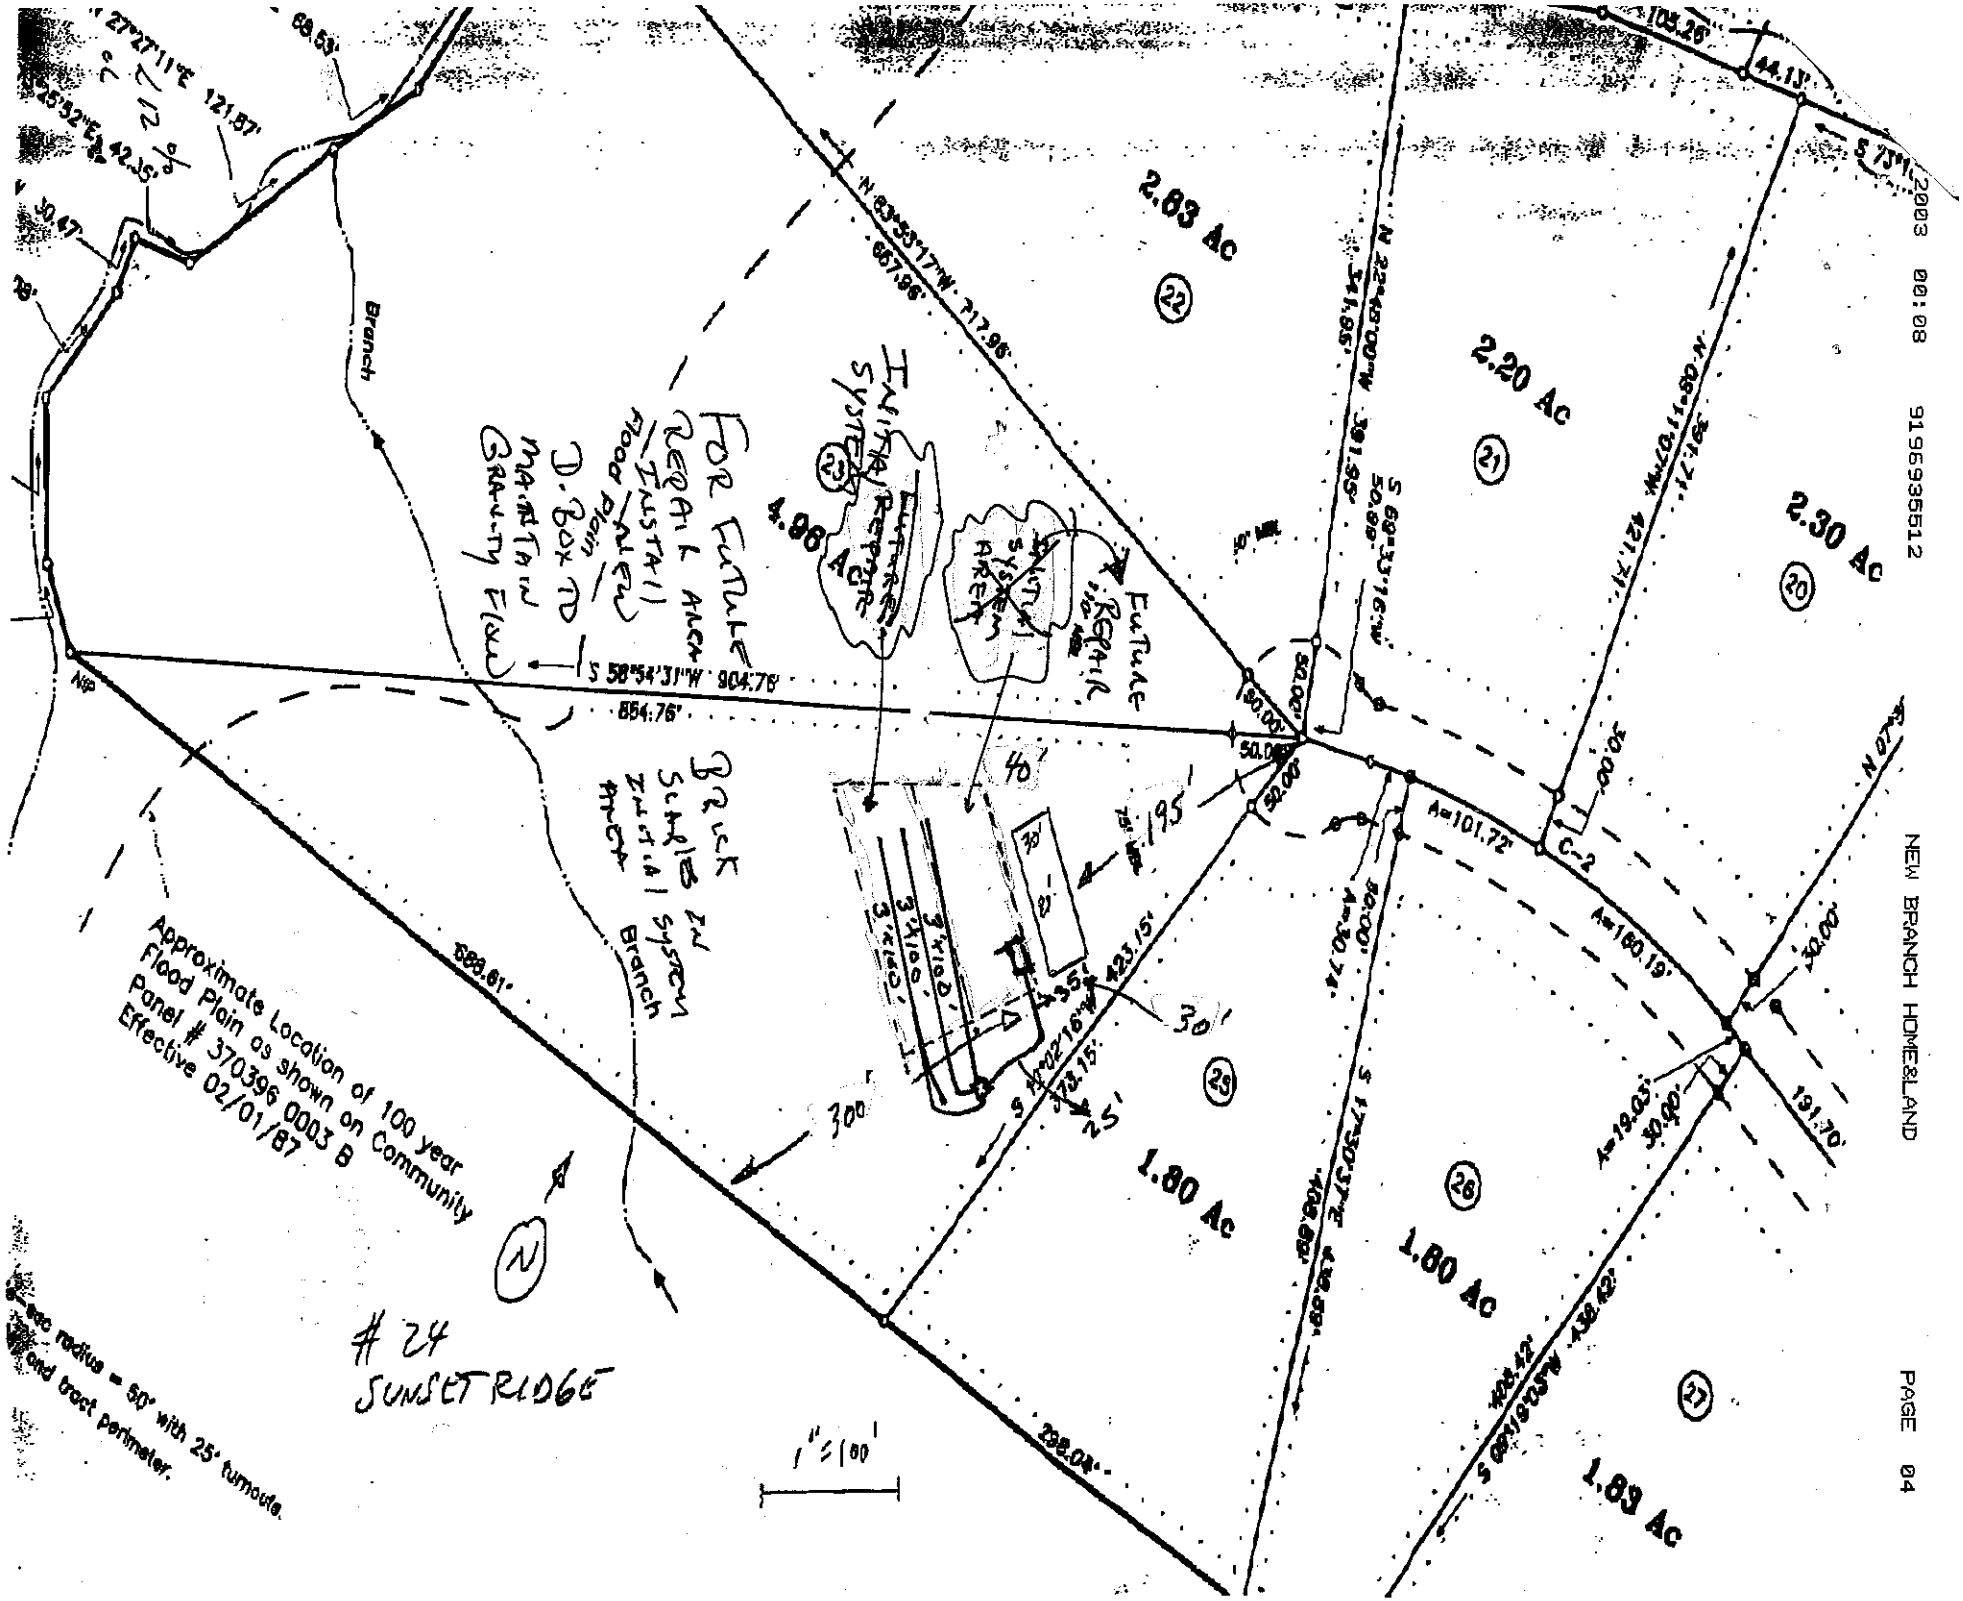
2.83 Ac
2.20 Ac
2.30 Ac
4.96 Ac
1.80 Ac
1.80 Ac
1.83 Ac
FOR FUTURE REPAIR AREA INSTALL FLOOD PLAIN NEW D. BOX TO MAINTAIN GRAVITY FLOW
INITIAL REPAIR SYSTEM
FUTURE REPAIR
INITIAL SYSTEM AREA
BRICK SCARPES IN INITIAL SYSTEM AREA
Branch
S 58°54'31"W 904.76'
854.76'
688.61'
298.04'
N 83°53'17"W 717.96'
667.96'
N 22°48'00"W 391.95'
S 69°33'16"W 50.99'
N 08°11'07"W 421.71'
S 17°30'37"E 438.89'
S 09°16'03"W 438.42'
A=101.72'
A=160.19'
A=19.03'
C-2
40'
195'
30'
25'
300'
30'
Approximate Location of 100 year Flood Plain as shown on Community Panel # 370396 0003 B Effective 02/01/87
24 SUNSET RIDGE
1" = 100'
radius = 50' with 25' turnout
and tract perimeter.