Environmental Services - Water Quality
Onsite Wastewater Scan Data Entry Form

PERMIT #: 0050307 PIN #: 0698941123

OP DATE: 05/13/2014

SYSTEM USE:
- [x] House
- [ ] Mobile Home
- [ ] Business
- [ ] Other

SEWAGE TYPE:
- [x] Domestic
- [ ] Industrial

PUMP/SIPHON?:
- [x] Yes
- [ ] No

PRESSURE MANIFOLD:
- [x] Yes
- [ ] No

SYSTEM TYPE:
- [ ] I
- [ ] II
- [x] III
- [ ] IV
- [ ] V
- [ ] VI
- [ ] Other

SUB TYPE:
- [ ] A
- [x] B
- [ ] C
- [ ] D
- [ ] E
- [ ] F
- [ ] G

NBR BEDROOMS:
- [ ] 1
- [ ] 2
- [ ] 3
- [x] 4
- [ ] 5
- [ ] 6
- [ ] Other

MAINT. SCHEDULE:
- [ ] Yes
- [x] No

CERT. OPERATOR
- [ ] Yes
- [x] No

GT	ST	PT	SIZE
☐	☐		750
☐	☐	☐	900
☐	☐	☐	1,000
☐	☒	☒	1,200
☐	☐	☐	1,500
☐	☐	☐	1,800
☐	☐	☐	2,100
☐	☐	☐	2,500
☐	☐	☐	3,000
☐	☐	☐	4,000
☐	☐	☐	5,000
☐	☐	☐	8,000
	☐	☐	10,000
☐	☐	☐	Other
☒		☐	None/NA GT or PT

DRAINFIELD SIZE(SQ. FT.)

0170

DRAIN TYPE:
- [ ] Stone
- [x] EZ Flow
- [ ] Infiltrator
- [ ] Biodiffuser
- [ ] Cultec
- [ ] Drip
- [ ] Hancor
- [ ] Large Dia. Pipe
- [ ] Multi-Pipe
- [ ] Other

MAX DEPTH (IN.):
- [ ] 12 in. or less
- [ ] 18 in. or less
- [ ] 24 in. or less
- [ ] 26 in. or less
- [ ] 28 in. or less
- [ ] 30 in. or less
- [ ] 32 in. or less
- [ ] 36 in. or less
- [x] Other

STONE DEPTH (IN.):
- [ ] 8 in. or less
- [x] 12 in. or less
- [ ] 18 in. or less
- [ ] 24 in. or less
- [ ] Other

TRENCHES:
- [x] Individual
- [ ] Bed

TRENCH WIDTH (IN.):
- [ ] 12 in. or less
- [ ] 18 in.
- [ ] 24 in.
- [x] 36 in.
- [ ] 6 ft. or less
- [ ] 9 ft. or less
- [ ] Other

WAKE COUNTY DEPARTMENT OF ENVIRONMENTAL SERVICES WELL AND SEWAGE SITE LOCATION PERMIT
NO PERMIT(S) FOR CONSTRUCTION, LOCATION OR RELOCATION ACTIVITY SHALL BE ISSUED
UNTIL AN AUTHORIZATION FOR WASTEWATER SYSTEM CONSTRUCTION HAS BEEN ISSUED
PERMIT VOID IF NOT IN COMPLIANCE WITH ZONING REGULATIONS AND/ OR IF SITE IS ALTERED OR INTENDED USE CHANGED

PERMIT#: **D050307** STATUS: **A** APP. DATE: **12/04/2013** BLDG. PERMIT#: **0141596**
PIN: **0698 94 1123 000** TAX MAP: **0** RECORDED: **Y** ORIG. PERMIT#:
TOWNSHIP: **15 PANTHER BRANCH** JURISDICTION: **WC** ZONING: **R30** SW DEVICE: **N** S#:
APPLICANT: **MERITAGE HOMES** **(602) 558 - 1293**
5400 TRINITY RD #107 **RALEIGH, NC 27607**
USE: HD USE: **101A CONVENTIONAL ONE-FAMILY HOUSE** EXIST USE:
LTAR: **0.35 0.35** BEDROOMS: **4** BASEMENT: **N** #EMPLOYEES: **0**
SITE: ADDRESS: **1604 WYNNE TRACE CT**
SUBDIVISION: **BRAXTON POINTE** LOT: **25** ACRES: **0.59** EASEMENT: **N** LOC: SYS:
DIRECTION: **401S L OLD STAGE L ROCK SERVICE STATION L OVERDALE L WYNNE TRACE**

Well System: WATER: **COMMUNITY** - TYPE:

WELL LOG INFORMATION: DEPTH: ____ CASING DEPTH: ____ YIELD: _____ STATIC LEVEL: _____
WELL CONTRACTOR: _____ REG.# _____ PUMP CONTRACTOR: _____ REG.# _____
Construction Compliance GROUT APPROVED ☐ DATE _____ EHS _____
WELLHEAD APPROVED ☐ DATE _____ EHS _____
SYSTEM FINALIZED ☐ DATE _____ EHS _____

COMMENTS:

Operation Permit

DESIGN FLOW: **26.81** gal/min. ACTUAL FLOW: _____ DOSE VOLUME: **190** gal. INNOVATIVE LETTER:
INSTALLED BY: Gulley Backhoe INSTALLATION APPROVED BY: Alan Alcock
PROPRIETARY SYSTEM: EZ FLOW TYPE SYSTEM: III B Poly/lock
COMMENTS:
OPERATIONS PERMIT ISSUED? Y OP DATE: 5/13/14 BY: TAH

Systems defined as either a Type IIIb, IIIg with a pump, IV, V or VI, in accordance with the North Carolina Administrative Code 15A NCAC 18A .1961, Table V as adopted by reference in the "Regulations Governing Wastewater Treatment and Dispersal Systems in Wake County", require Wake County Environmental Services to conduct periodic inspections on this type system, pursuant to 15A NCAC 18A .1961 (j). Fees for these inspections will be charged as per the approved Fee Schedule. In addition, all systems are to be operated and maintained as specified in 15A NCAC 18A .1961. This permit is based in part on information provided by the homeowner or his/her representative in the application submitted for this permit. The Environmental Health Specialist is not responsible for false or misleading information contained in the application. The Environmental Health Specialist is also not responsible for concealed conditions on the property or for statements in this report that may have resulted from false or misleading statements provided to him in the application. Neither Wake County nor the Environmental Health Specialist warrants that the septic tank system will continue to function satisfactorily in the future or that the water supply will remain potable.

As Built Information:
Date: 4/22/14 Benchmark: ST Rod reading: 12'1" Distance to Structure: 13'1/2"
ST: 1200 gals ID#: 85-T D.O.M.: 3/12/14 Elev.: 12'4" Distance to Well: NA
PT: 1200 gals ID#: 170 D.O.M.: 2/28/14 Elev.: 12'8" Distance to P/L: _____
GT: _____ gals ID#: _____ D.O.M.: _____ Elev.: _____ Pretreatment: _____
D-box/FD/PM Elev.: 10'5 1/2" Supply Line: _____ ft. Pump/Ctrl Panel: _____ Filter: _____
Line 1: 13'2" ____ ____ ____ Date: 4/22/14 Line 6: ____ ____ ____ ____ Date: ____
Line 2: 13'8" ____ ____ ____ Date: ____ Line 7: ____ ____ ____ ____ Date: ____
Line 3: 14'1/2" ____ ____ ____ Date: ____ Line 8: ____ ____ ____ ____ Date: ____
Line 4: 14'4" ____ ____ ____ Date: ____ Line 9: ____ ____ ____ ____ Date: ____
Line 5: ____ ____ ____ ____ Date: ____ Line 10: ____ ____ ____ ____ Date: ____
ETM1: _____ CC1: _____ ETM2: _____ CC2: _____ OR: _____ AC: _____ WM: _____
Notes: _____

ES Copy

WAKE COUNTY DEPARTMENT OF ENVIRONMENTAL SERVICES WELL AND SEWAGE SITE LOCATION PERMIT
NO PERMIT(S) FOR CONSTRUCTION, LOCATION OR RELOCATION ACTIVITY SHALL BE ISSUED
UNTIL AN AUTHORIZATION FOR WASTEWATER SYSTEM CONSTRUCTION HAS BEEN ISSUED
PERMIT VOID IF NOT IN COMPLIANCE WITH ZONING REGULATIONS AND/ OR IF SITE IS ALTERED OR INTENDED USE CHANGED

PERMIT#: **D050307** STATUS: **A** APP. DATE: **12/04/2013** BLDG. PERMIT#: **0141596**
PIN: **0698 94 1123 000** TAX MAP: **0** RECORDED: **Y** ORIG. PERMIT#:
TOWNSHIP: **15 PANTHER BRANCH** JURISDICTION: **WC** ZONING: **R30** SW DEVICE: **N** S#:
APPLICANT: **MERITAGE HOMES** **(602) 558 - 1293**
5400 TRINITY RD #107 **RALEIGH, NC 27607**
HD USE: **101A CONVENTIONAL ONE-FAMILY HOUSE** EXIST USE: DESIGN FEE REQ?: **Y** PAID?: **Y**
LTAR: **0.35 0.35** BEDROOMS: **4** BASEMENT: **N** #EMPLOYEES: **0** FOUNDATION DRAIN: **Y**
SITE: ADDRESS: **1604 WYNNE TRACE CT**
SUBDIVISION: **BRAXTON POINTE** LOT: **25** ACRES: **0.59** EASEMENT: **N** LOC: SYS:
DIRECTION: **401S L OLD STAGE L ROCK SERVICE STATION L OVERDALE L WYNNE TRACE**

IMPROVEMENT PERMIT

As per GS 130A-335 (f), Improvement Permit is based on a Site Plan and is void Sixty (60) months from date of issuance: ☐
As per GS 130A-335 (f), Improvement Permit is based on a Plat and is valid without expiration: ☒
Permit is subject to revocation if the site plan or plat, whichever is applicable, or the intended use changes.

TANK SIZE: **1200** gal. PUMP Tank: **1200** gal. GREASE TRAP: gal. SQ FT: **1170** **ACCEPTED STATUS** MAX DEPTH LINE: **21** in.
WASTEWATER: **INDIVIDUAL** SEWAGE: **DOMESTIC** TYPE SYSTEM: **III B** PUMP: **Y** P/M: **Y** LP: **N** TD: **N**
DAILY FLOW: **480** gal/day WATER: **COMMUNITY** PRETREATMENT: **NA** FILL: **N** DAF: **N** DEEP: **N** REDUCE35%: **N**

COMMENTS:

IP ISSUED? **Y** DATE: **12/30/2013** BY: **(TAH)** Travis Howard PHONE#: **(919)-369-5974**

AUTHORIZATION FOR WASTEWATER/WATER SYSTEM CONSTRUCTION
VOID SIXTY (60) MONTHS FROM DATE OF ISSUANCE
AUTHORIZATION CONDITIONS:

Contractors shall install system on contours, see attached site plan for wastewater system design and well location. No underground utilities, water lines or sprinkler systems may be located in the original system or repair areas. A septic tank filter with a riser for access is required. The wastewater system shall not be covered or placed into use until inspected by the Wake County Department of Environmental Services and an Operation Permit issued. An Accepted Status System may be used in place of conventional system, if it can be placed in the permitted/authorized trench footprint (except reduction in line length and/or number as allowed for in approval) and the installation is in accordance with the accepted system approval, without unauthorized product alteration. If permit required use of an Accepted Status System, substitution with another accepted status system may be made, as long as no changes are necessary in the location of each nitrification line (including any increase in line length), trench depth or effluent distribution method. If changes are necessary, prior approval by this office is required before system installation.

OTHER CONDITIONS: **ACCEPTED STATUS SYSTEM REDUCTION HAS BEEN TAKEN FOR THE DESIGN OF INITIAL AND REPAIR SYSTEMS. PLEASE SEE DESIGN PLANS BY BCSC, PC. (APPROVED 01-10-14 BY BSM) FOR INSTALLATION INFORMATION. INITIAL SYSTEM IS A VARIED LENGTH LINE PRESSURE MANIFOLD WITH 21 INCH TRENCH BOTTOMS. WHEN INSTALLING DRAINLINES, PLEASE MAINTAIN ALL REQUIRED SETBACKS. REPAIR SYSTEM IS A VARIED LENGTH LINE PRESSURE MANIFOLD WITH 21 INCH TRENCH BOTTOM. WHEN CLEARING AREA FOR INITIAL SYSTEM, DO NOT DISTURB OR REMOVE ANY SOIL FROM EITHER THE INITIAL OR REPAIR AREA. A NEMA4X CONTROL PANEL WITH TWO BREAKERS, TWO POWER SUPPLIES, ELASPED TIME METER, AND CYCLE COUNTER IS REQUIRED. INSTALL TRENCHES ON CONTOUR AND > OR = 9FT ON CENTER. PUMP TANK MUST BE SET SO THAT THE TOP SEAM OF THE PUMP TANK IS BELOW THE BOTTOM OF THE OUTLET ON THE SEPTIC TANK. MUST MAINTAIN REQUIRED EMERGENCY STORAGE IN PUMP TANK. PLEASE CALL ENVIRONMENTAL SERVICES IF ANY QUESTIONS OR PROBLEMS ARISE.**

TANK SIZE: **1200** gal. PUMP TANK: **1200** gal. GREASE TRAP: gal. SQ FT: **1170** **ACCEPTED STATUS** MAX DEPTH LINE: **21** in.
MAINT: **N** OPER: **N** L/O: **P** TRENCH#: **4** LENGTH: **390** ft. WIDTH: **36** in. DESIGNER: **BCSC, PC**
SUBFIELDS: **1** DESIGN HEAD PRESSURE: **2** DESIGN FLOW: **26.81** gal/min DOSE VOLUME: **190** gal. PRETREATMENT: **NA**

CA ISSUED? **Y** DATE: **01/10/2014** BY: **(BSM)** PHONE#: **(919)-856-7463**

ALL DIMENSIONS, LOCATIONS AND FEATURES SHOWN ON THIS PLOT PLAN ARE APPROXIMATE AND ARE ONLY AN ARTISTS RENDITION, EXACT LOCATION OF ALL FEATURES ARE SUBJECT TO CHANGE AND MAY NOT BE INSTALLED EXACTLY AS SHOWN ON PLANS AND/OR IN MODELS, PLACEMENT OF HOME, DRIVEWAY, SIDEWALKS AND EXTERIOR FEATURES ARE SUBJECT TO MODIFICATION AS DEEMED NECESSARY BY FIELD PERSONNEL.

CUSTOMER DATE

CUSTOMER DATE

MERITAGE REPRESENTATIVE DATE

REID: 0415368
ADDRESS = 1604 WYNN TRACE COURT
TOTAL LOT AREA = 0.586 AC = 25,543 SF
MAXIMUM IMPERVIOUS = 4,520 SF — MISA
HOUSE = 3,502 SF
DRIVEWAY = 424 SF
SIDEWALK = 116 SF
PORCH = 182 SF
SCREENED PORCH = 129 SF
TOTAL PROPOSED IMPERVIOUS = 4,353 SF
PERCENT IMPERVIOUS = 17.0 %

64.0

22.2

DW

)'

VIAN CIVIL SURVEY CO.,
. CARSON, PLS.

AYOUT AND PERMITTING

OPERTY LINES SHOWN
IDENCE, EXISTING DEEDS
NFORMATION SUPPLIED TO

ITITUDE, LONGITUDE AND
N, ARE GIVEN IN NORTH

L STATION, EPOCH 35.

UND DISTANCES AND ALL
TE PLANE COORDINATE

AND HAS NOT BEEN
AGENCY FOR COMPLIANCE
MENT REGULATIONS.

ATIONAL FLOOD
NCE RATE MAP NUMBER

I certify that the location of planned or existing structure(s) are accurately shown. I understand failure to locate structures in accordance with this plot plan may require the relocation of structure(s) regardless degree of completion. I hereby grant permission to Municipal/County Representatives the right of entry to make evaluations or inspections upon this property.

Signature of Owner or Authorized Agent

26

Zoning R30 L By KAS
Approve Date 12-4-13
Revise Use 101A
Reject MBL
Front 15 Rear 15
5 Corner

S OF NC, INC.
AD, RALEIGH, NC 27607.

BEARING	CHD LENGTH
°46'08"E	78.08

comments: SFD-cluster

N74°11'35"E
147.31'

30' PERIMETER BUILDING SETBACK

30' PERIMETER BUILDING SETBACK

Repair Area

Repair Area

S09°23'30"W
115.68

23

5' SIDE YARD SETBACK

S 05°40'07" E
215.52'

25,[illegible] SF
0.5[illegible] AC

5' SIDE YARD SETBACK

20.1'

13.1'

PROPOSED
MODEL
260-3015 "B"

S 09°23'30"W
143.96'

13.0'

15' FRONT YARD SETBACK

21.0'

DW

25.2'

12.5'

C1

24


EZ Flow System

0141[illegible]
D05030

1604
WYNNE TRACE COURT
PUBLIC 50' R/W

CA Site Plan Part A
PIN# 0698941123
D050307 Braxton Pointe lot 25

* See CA Site Plan Part B + Design Plan (Approved HO-Hwy 65th) for installation info.

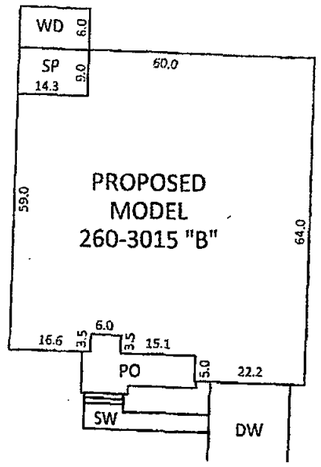

INSET SCALE: 1"=30'

NOTE:

ALL DIMENSIONS, LOCATIONS AND FEATURES SHOWN ON THIS PLOT PLAN ARE APPROXIMATE AND ARE ONLY AN ARTISTS RENDITION, EXACT LOCATION OF ALL FEATURES ARE SUBJECT TO CHANGE AND MAY NOT BE INSTALLED EXACTLY AS SHOWN ON PLANS AND/OR IN MODELS, PLACEMENT OF HOME, DRIVEWAY, SIDEWALKS AND EXTERIOR FEATURES ARE SUBJECT TO MODIFICATION AS DEEMED NECESSARY BY FIELD PERSONNEL.


CUSTOMER _____ DATE

CUSTOMER _____ DATE

MERITAGE REPRESENTATIVE _____ DATE

LOT INFORMATION:

LOT #25
PIN= 0698941123
REID: 0415368
ADDRESS = 1604 WYNN TRACE COURT
TOTAL LOT AREA = 0.586 AC = 25,543 SF
MAXIMUM IMPERVIOUS = 4,520 SF – MISA
HOUSE = 3,502 SF
DRIVEWAY = 424 SF
SIDEWALK = 116 SF
PORCH = 182 SF
SCREENED PORCH = 129 SF
TOTAL PROPOSED IMPERVIOUS = 4,353 SF
PERCENT IMPERVIOUS = 17.0 %

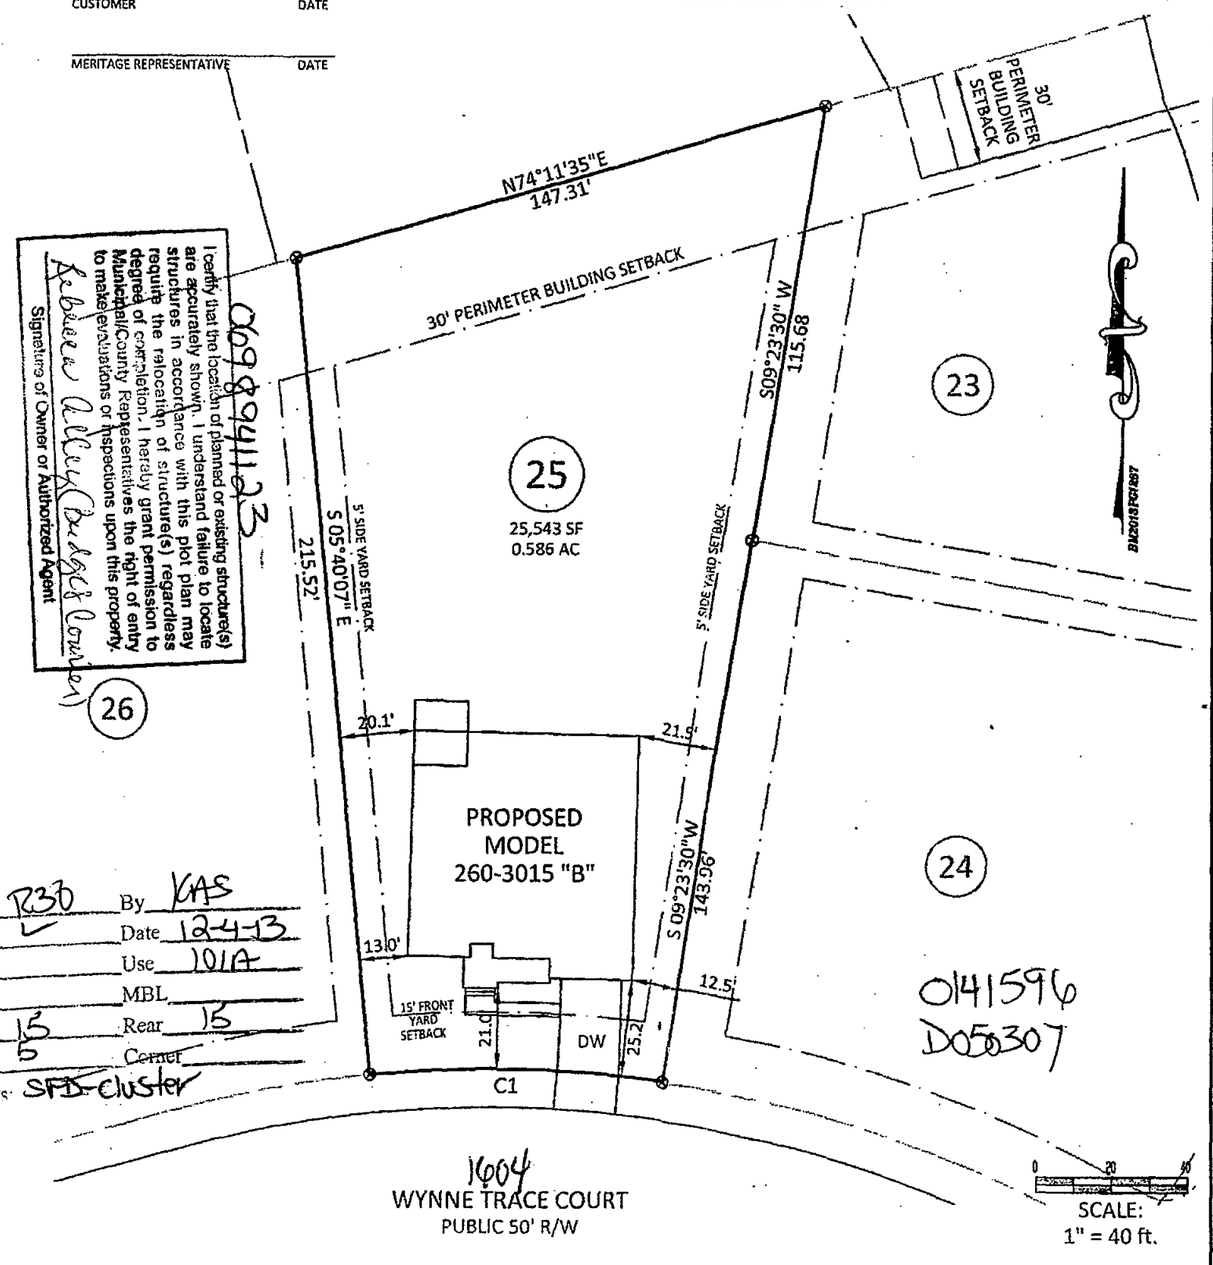

I certify that the location of planned or existing structure(s) are accurately shown. I understand failure to locate structures in accordance with this plot plan may require the relocation of structure(s) regardless degree of completion. I hereby grant permission to Municipal/County Representatives the right of entry to make evaluations or inspections upon this property.

0698941123

Signature of Owner or Authorized Agent

Zoning R30 By KAS
Approve ✓ Date 12-4-13
Revise _____ Use 101A
Reject _____ MBL _____
Front 15 Rear 15
Corner 10
Comments: SFD cluster

CURVE	LENGTH	RADIUS	CHD BEARING	CHD LENGTH
C1	78.27	325.00	S88°46'08"E	78.08

NOTES:

1. THIS SURVEY WAS PREPARED BY BATEMAN CIVIL SURVEY CO., UNDER THE SUPERVISION OF STEVEN P. CARSON, PLS.
2. THIS PLAN HAS BEEN PREPARED FOR LAYOUT AND PERMITTING PURPOSES ONLY.
3. THIS IS NOT A BOUNDARY SURVEY. PROPERTY LINES SHOWN WERE TAKEN FROM EXISTING FIELD EVIDENCE, EXISTING DEEDS AND PLATS OF PUBLIC RECORD, AND INFORMATION SUPPLIED TO THE SURVEYOR BY THE CLIENT
4. VERTICAL DATUM IS ASSUMED. THE LATITUDE, LONGITUDE AND STATE PLANE COORDINATES, IF SHOWN, ARE GIVEN IN NORTH AMERICAN DATUM OF 1983 (NAD83).
5. FIELD EQUIPMENT USED: NIKON TOTAL STATION, EPOCH 35.
6. ALL DISTANCES ARE HORIZONTAL GROUND DISTANCES AND ALL BEARINGS ARE NORTH CAROLINA STATE PLANE COORDINATE SYSTEM UNLESS OTHERWISE SHOWN.
7. THIS MAP IS NOT A CERTIFIED SURVEY AND HAS NOT BEEN REVIEWED BY A LOCAL GOVERNMENT AGENCY FOR COMPLIANCE WITH ANY APPLICABLE LAND DEVELOPMENT REGULATIONS.
8. THE PROPERTY LIES IN ZONE "X" PER NATIONAL FLOOD INSURANCE PROGRAM FLOOD INSURANCE RATE MAP NUMBER 3720069800J, DATED MAY 2, 2006.
9. ZONING IS R30.
10. PROPERTY OWNER: MERITAGE HOMES OF NC, INC. 5400 TRINITY ROAD, RALEIGH, NC 27607.

Bateman Civil Survey Company
Engineers • Surveyors • Planners
200 N. Main Street, Holly Springs, NC 27540 Ph: 919.577.1080 Fax: 919.577.1081
www.batemancivilsurvey.com info@batemancivilsurvey.com
NCBELS Firm No. C-2378



VICINITY MAP
(Not to Scale)

LEGEND

PO = PORCH
SP = SCREENED PORCH
CP = COVERED PORCH
WD = WOOD DECK
SW = SIDEWALK
DW = CONC DRIVEWAY
⊗ = CONTROL POINT
○ = IRON PIPE FOUND
◉ = IRON PIPE SET
● = DRILL HOLE FOUND
WM = WATER METER
CO = CLEAN OUT
AC = AIR CONDITIONER
Ⓢ = SEWER MANHOLE
EB = ELECTRIC BOX
Ⓒ = CABLE BOX
☐ = TELEPHONE PEDESTAL
CI = CURB INLET
TUA = TRANSITIONAL USE AREA
☼ = LIGHT POLE

BUILDING SETBACKS:

FRONT = 15 ft
REAR = 15 ft
SIDE = 5 ft
CORNER = 15 ft

I hereby certify that this map is correct and that the building lies wholly on the lot and that there are no visible encroachments on said lot.

PRELIMINARY

Steven P. Carson, PLS 4752
Date

This map is of an existing parcel of land and is only intended for the parties and purposes shown. This map not for recordation. No title report provided.

APPROVAL FOR STAKING:

THIS PLOT PLAN AS PREPARED BY BATEMAN CIVIL SURVEY CO., IS CORRECT AND IS HEREBY APPROVED FOR STAKING ON THE DATE AS SHOWN BELOW.

MERITAGE HOMES REPRESENTATIVE _____ DATE _____

PRELIMINARY PLOT PLAN - LOT 25

FOR

MeritageHomes

BRAXTON POINTE - LOT 25
1604 WYNNE TRACE COURT, RALEIGH, NC
PANTHER BRANCH TOWNSHIP, WAKE COUNTY

DATE: 11/19/13 DRAWN BY: JKF CHECKED BY: SPC

REFERENCE: BM 2013, PG 1267 SCALE: 1" = 40'

CA Site Plan Part B
PIN#0698941123
D050307 Braxton Pointe lot 25

*See CA Site Plan Part A + Design Plan (Approved 1-10-14 by BSM) for installation info.

LINE SCHEDULE

LINE NUMBER	COLOR	FIELD ELEVATION	LENGTH
1	ORANGE	3.6	120
2	YELLOW	3.9	85
3	WHITE	3.9	70
4	PINK	4.0	80
5	BLUE	4.3	100
6	RED	4.6	100
7	GREEN	4.8	110
8	ORANGE	5.0	90
9	YELLOW	5.2	55

LOT 25 BRAXTON POINT

4-BEDROOM PRESSURE MANIFOLD SYSTEM
LINES 4-7
EZFLOW
LTAR 0.35


4-BEDROOM PRESSURE MANIFOLD REPAIR
LINES 1-3,8-9
EZFLOW
LTAR 0.35

FOR GENERAL USE NOT A SURVEY
PRELIMINARY NOT FOR CONSTRUCTION

*Drainlines must be ≥ 9' on center, on contour, ≥ 10' off property line & ≥ 15' side slope of foundation drain,

*Manifold & supply line must be ≥ 5' off PL.

*Tanks must be ≥ 10' off PL & ≥ 15' side slope of foundation drain

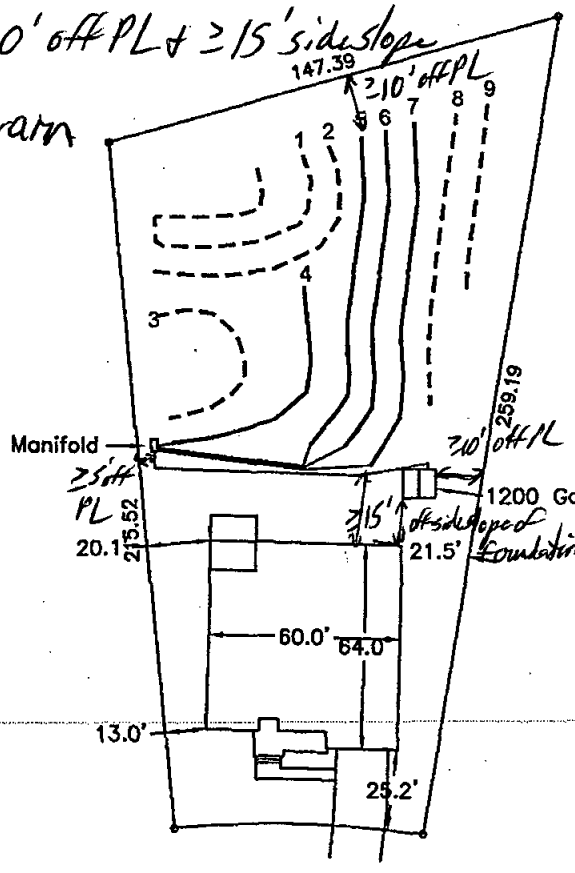

0 30 60
SCALE:
1" = 60 ft.

Bateman Civil Survey Company
Engineers • Surveyors • Planners
209 N. Main Street, Holly Springs, NC 27540 Ph: 919.577.1080 Fax: 919.577.1081
www.batemancivilsurvey.com Info@batemancivilsurvey.com
NCBELS Firm No. C-2376

MeritageHomes

LOT 25
5512 Overdale Lane, Raleigh, NC
WAKE COUNTY

DATE: 12/02/13 DRAWN BY: AH CHECKED BY: TMB

ES Copy

PRESSURE MANIFOLD
Septic System Design

for

BRAXTON POINT LOT 25
Raleigh, North Carolina

Designed by:

AARON HOLDER
Bateman Civil Survey Company, PC
Holly Springs, North Carolina
BCSC Project #: 120424.025

( ) APPROVED
(X) APPROVED AS NOTED
( ) DISAPPROVED

Review of this document has been made only for conformance with the design concept of the project and approval or approval as noted shall not relieve the designer and/or contractor from responsibility for any errors therein or for furnishing the materials, and equipment of proper dimension, size, quantity, quality and all performance characteristics to meet the requirements and intent of the contract documents.

WAKE COUNTY DEPARTMENT OF
ENVIRONMENTAL SERVICES

Date 1-10-14 By

11/03/13