Granville – Vance District Health Department
Environmental Health

Pin 1813002949 02 Permit Number 7228

✓ Improvement Permit ✓ Construction Authorization

Final Sketch

Matt Baldwin Homes — Applicants Name
Hawthorne 66 — Subdivision – Section – Lot
Physical Address: Hawthorne Place
Blackley Brothers — System Installer
8-30-12 — Date


System design and details as installed.

Septic Tank Information:
Date: 6-10-10
Manufacture: Ellis 1200 gal
ID #: 578-322

Pump Tank Information:
Date:
Manufacturer:
ID #:

Distribution Box ✓
Pressure Manifold
Serial Distribution
Pump Info:

Type of Facility: House
Number of Bedrooms: 4
Type of System: X Gravity ___ Pump ___ Gravel ___ Polystyrene ___ Chamber ___ Other: ___

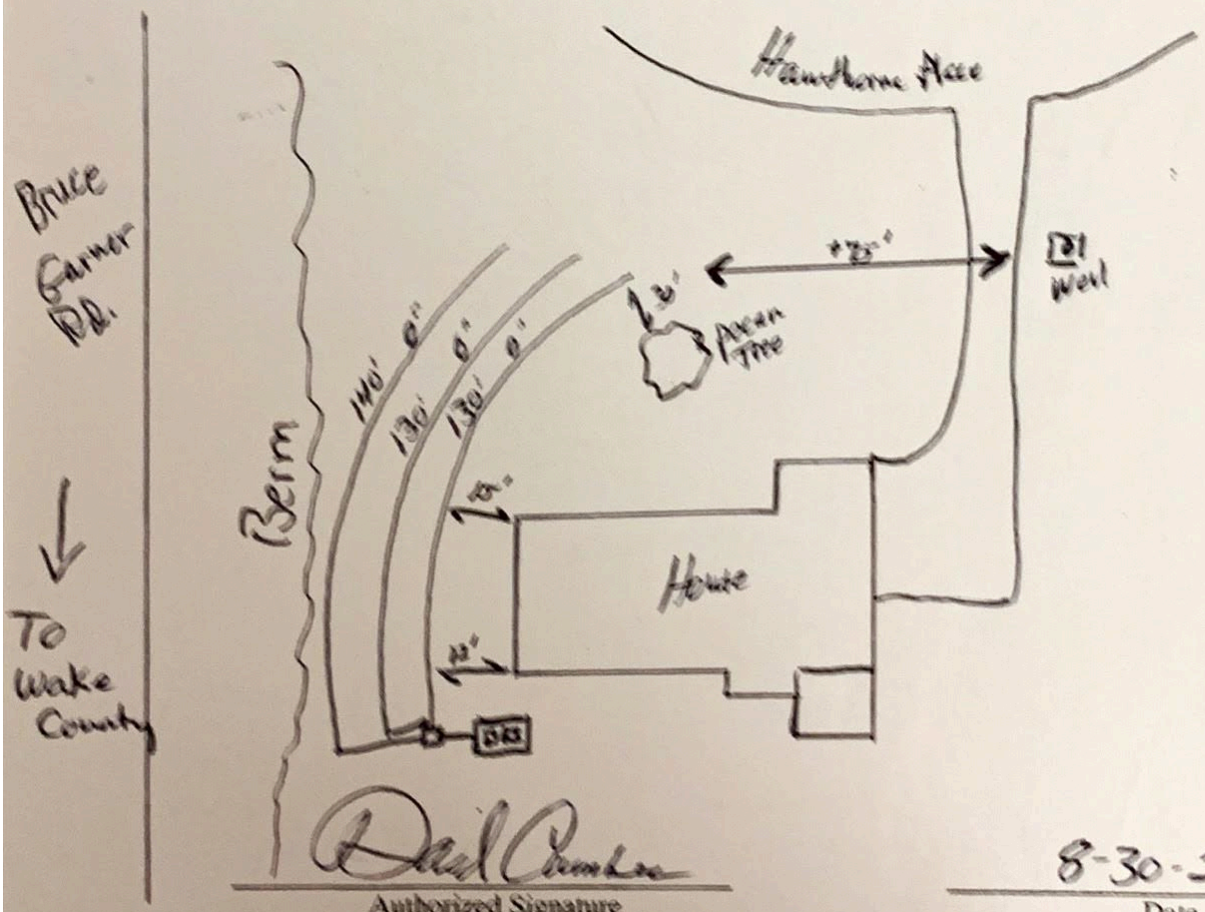

Authorized Signature

8-30-2012
Date