Environmental Services - Water Quality
Onsite Wastewater Scan Data Entry Form

PERMIT #: 0010454 PIN #: 0780705912

OP DATE: 02/24/1999

SYSTEM USE:
- [X] House
- [ ] Mobile Home
- [ ] Business
- [ ] Other

SEWAGE TYPE:
- [X] Domestic
- [ ] Industrial

PUMP/SIPHON?:
- [ ] Yes
- [X] No

PRESSURE MANIFOLD:
- [ ] Yes
- [X] No

SYSTEM TYPE:
- [ ] I
- [X] II
- [ ] III
- [ ] IV
- [ ] V
- [ ] VI
- [ ] Other

SUB TYPE:
- [X] A
- [ ] B
- [ ] C
- [ ] D
- [ ] E
- [ ] F
- [ ] G

NBR BEDROOMS:
- [ ] 1
- [ ] 2
- [ ] 3
- [X] 4
- [ ] 5
- [ ] 6
- [ ] Other

MAINT. SCHEDULE:
- [ ] Yes
- [X] No

CERT. OPERATOR
- [ ] Yes
- [X] No

GT	ST	PT	SIZE
[ ]	[ ]		750
[ ]	[ ]	[ ]	900
[ ]	[ ]	[ ]	1,000
[ ]	[X]	[ ]	1,200
[ ]	[ ]	[ ]	1,500
[ ]	[ ]	[ ]	1,800
[ ]	[ ]	[ ]	2,100
[ ]	[ ]	[ ]	2,500
[ ]	[ ]	[ ]	3,000
[ ]	[ ]	[ ]	4,000
[ ]	[ ]	[ ]	5,000
[ ]	[ ]	[ ]	8,000
	[ ]	[ ]	10,000
[ ]	[ ]	[ ]	Other
[X]		[X]	None/NA GT or PT

DRAINFIELD SIZE(SQ. FT.)
0350

DRAIN TYPE:
- [X] Stone
- [ ] EZ Flow
- [ ] Infiltrator
- [ ] Biodiffuser
- [ ] Cultec
- [ ] Drip
- [ ] Hancor
- [ ] Large Dia. Pipe
- [ ] Multi-Pipe
- [ ] Other

MAX DEPTH (IN.):
- [ ] 12 in. or less
- [ ] 18 in. or less
- [ ] 24 in. or less
- [ ] 26 in. or less
- [X] 28 in. or less
- [ ] 30 in. or less
- [ ] 32 in. or less
- [ ] 36 in. or less
- [ ] Other

STONE DEPTH (IN.):
- [ ] 8 in. or less
- [X] 12 in. or less
- [ ] 18 in. or less
- [ ] 24 in. or less
- [ ] Other

TRENCHES:
- [X] Individual
- [ ] Bed

TRENCH WIDTH (IN.):
- [ ] 12 in. or less
- [ ] 18 in.
- [ ] 24 in.
- [X] 36 in.
- [ ] 6 ft. or less
- [ ] 9 ft. or less
- [ ] Other

DH 11/6

WAKE COUNTY DEPARTMENT OF ENVIRONMENTAL SERVICES WELL AND SEWAGE SITE LOCATION PERMIT

NO PERMIT(S) FOR CONSTRUCTION, LOCATION OR RELOCATION ACTIVITY SHALL BE ISSUED
UNTIL AN AUTHORIZATION FOR WASTEWATER SYSTEM CONSTRUCTION HAS BEEN ISSUED
PERMIT VOID IF NOT IN COMPLIANCE WITH ZONING REGULATIONS AND/ OR IF SITE IS ALTERED OR INTENDED USE CHANGED

PERMIT#: D010454 STATUS: A APP DATE: 05/01/1998 BLDG PERMIT#: 0983867
APPLICANT: CROWDER, KENNETH R DAY PHONE: (919) 553 - 6180
ADDRESS: PO BOX 160 FAX#: (999) 999 - 9999
CITY: CLAYTON STATE: NC ZIP: 27609
OWNER: PERRY, ANTHONY B SR & PAT DAY PHONE: (999) 999 - 9999
ADDRESS: 7670 BRYAN RD FAX#: (999) 999 - 9999
CITY: GARNER STATE: NC ZIP: 27529
HD USE CD: 101 ONE-FAMILY HOUSE ORIG PERMIT#: REC?: Y
EXIST USE: TAX MAP#: 0723 0009
BEDROOMS: 4 BSMT: N #EMPLOYEES: 0 WATER: C WASTEWATER: I GARB DISPOSL: N
TOWNSHIP: 18 SWIFT CREEK JURIS: WC ZON: R40 PIN: 0780.04 62 5193 000
SUBD#: S 000 000 00 SUBD NAME: FOXMOOR LOT-SEC: 3 ACRE: 0.69
IMPRV PRMT: ISSUED?: Y DATE: 06/23/1998 BY: IW TYPE SYSTEM: II PUMP:
CNSTR AUTH: ISSUED?: Y DATE: 06/23/1998 BY: IW DATE EXPIRED: 06/23/2003
RECEIPT#: 0028066 FEE: 145.00 OP DATE: BY:
WATR SAMPL: REQ?: N APPROVED?: DATE: PROPRIETARY SYS:
ST#: 1813 MI: DIR: NAME: FOXBROOK DIR: TYP: DR
DIRECTIONS: 401S R HWY 1010 R LAKE WHEELER .4 MI ON L

IMPROVEMENT PERMIT

SIZE OF TANK 1200 ST ___ PT GALS. TOTAL SQ. FT. 1350 DEPTH OF STONE 12 IN. MAX. DEPTH LINE 18-28 IN.

WASTEWATER: DOMESTIC ☒ INDUSTRIAL ☐ I.P. ISSUED BY [signature] RSI

AUTHORIZATION FOR WASTEWATER SYSTEM CONSTRUCTION
VOID SIXTY (60) MONTHS FROM DATE OF ISSUANCE
AUTHORIZATION CONDITIONS

Contractor To Follow Contours, See Attached Site Plan For Wastewater System Design And Well Location. The wastewater system shall not be covered or placed into use until inspected by the Wake County Department of Environmental Services and an Operation Permit issued.

OTHER CONDITIONS: **Note and maintain contour. Do not exceed maximum trench depth. Maintain setbacks from property lines and from dwelling.**

SIZE OF TANK 1200 ST ___ PT GALS. TOTAL SQ. FT. 1350 DEPTH OF STONE 12 IN. MAX. DEPTH LINE 18-28 IN.
ST FILTER REQUIRED ☒ NUMBER OF TRENCHES 3 LENGTH OF TRENCHES 150 FT. WIDTH OF TRENCHES 3 FT.

C.A. ISSUED BY [signature] RSI INSTALLED BY Jeff Thompson CTR. I.D. #_____
SEPTIC TANK FILTER USED _____
INNOV. APPRL. #: IWWS-_____ DATE 2-24-99 INSTALLATION APPROVED BY Dave Parnell

WELL SYSTEM = PRIVATE ☐ SEMI-PUBLIC ☐ ///// NEW ☐ REPLACEMENT ☐ EXISTING ☐


WELL LOG INFORMATION = DEPTH _____ CASING DEPTH _____ YIELD _____ STATIC LEVEL _____
WELL CONTRACTOR _____ **REG.#** _____ **PUMP CONTRACTOR** _____ **REG.#** _____

CONSTRUCTION COMPLIANCE = GROUT APPROVED ☐ DATE _____ EHS _____
WCHD ID # _____ WELLHEAD APPROVED ☐ DATE _____ EHS _____
NEGATIVE BACTERIOLOGICAL RESULTS ☐ DATE _____ EHS _____
SYSTEM FINALIZED ☐ DATE _____ EHS _____

COMMENTS: _____

****

This permit is based in part on information provided by the homeowner or his/her representative in the application submitted for this permit. The Environmental Health Specialist is not responsible for false or misleading information contained in the application. The Environmental Health Specialist is also not responsible for concealed conditions on the property or for statements in this report that may have resulted from false or misleading statements provided to him in the application. Neither Wake County nor the Environmental Health Specialist warrants that the septic tank system will continue to function satisfactorily in the future or that the water supply will remain potable.

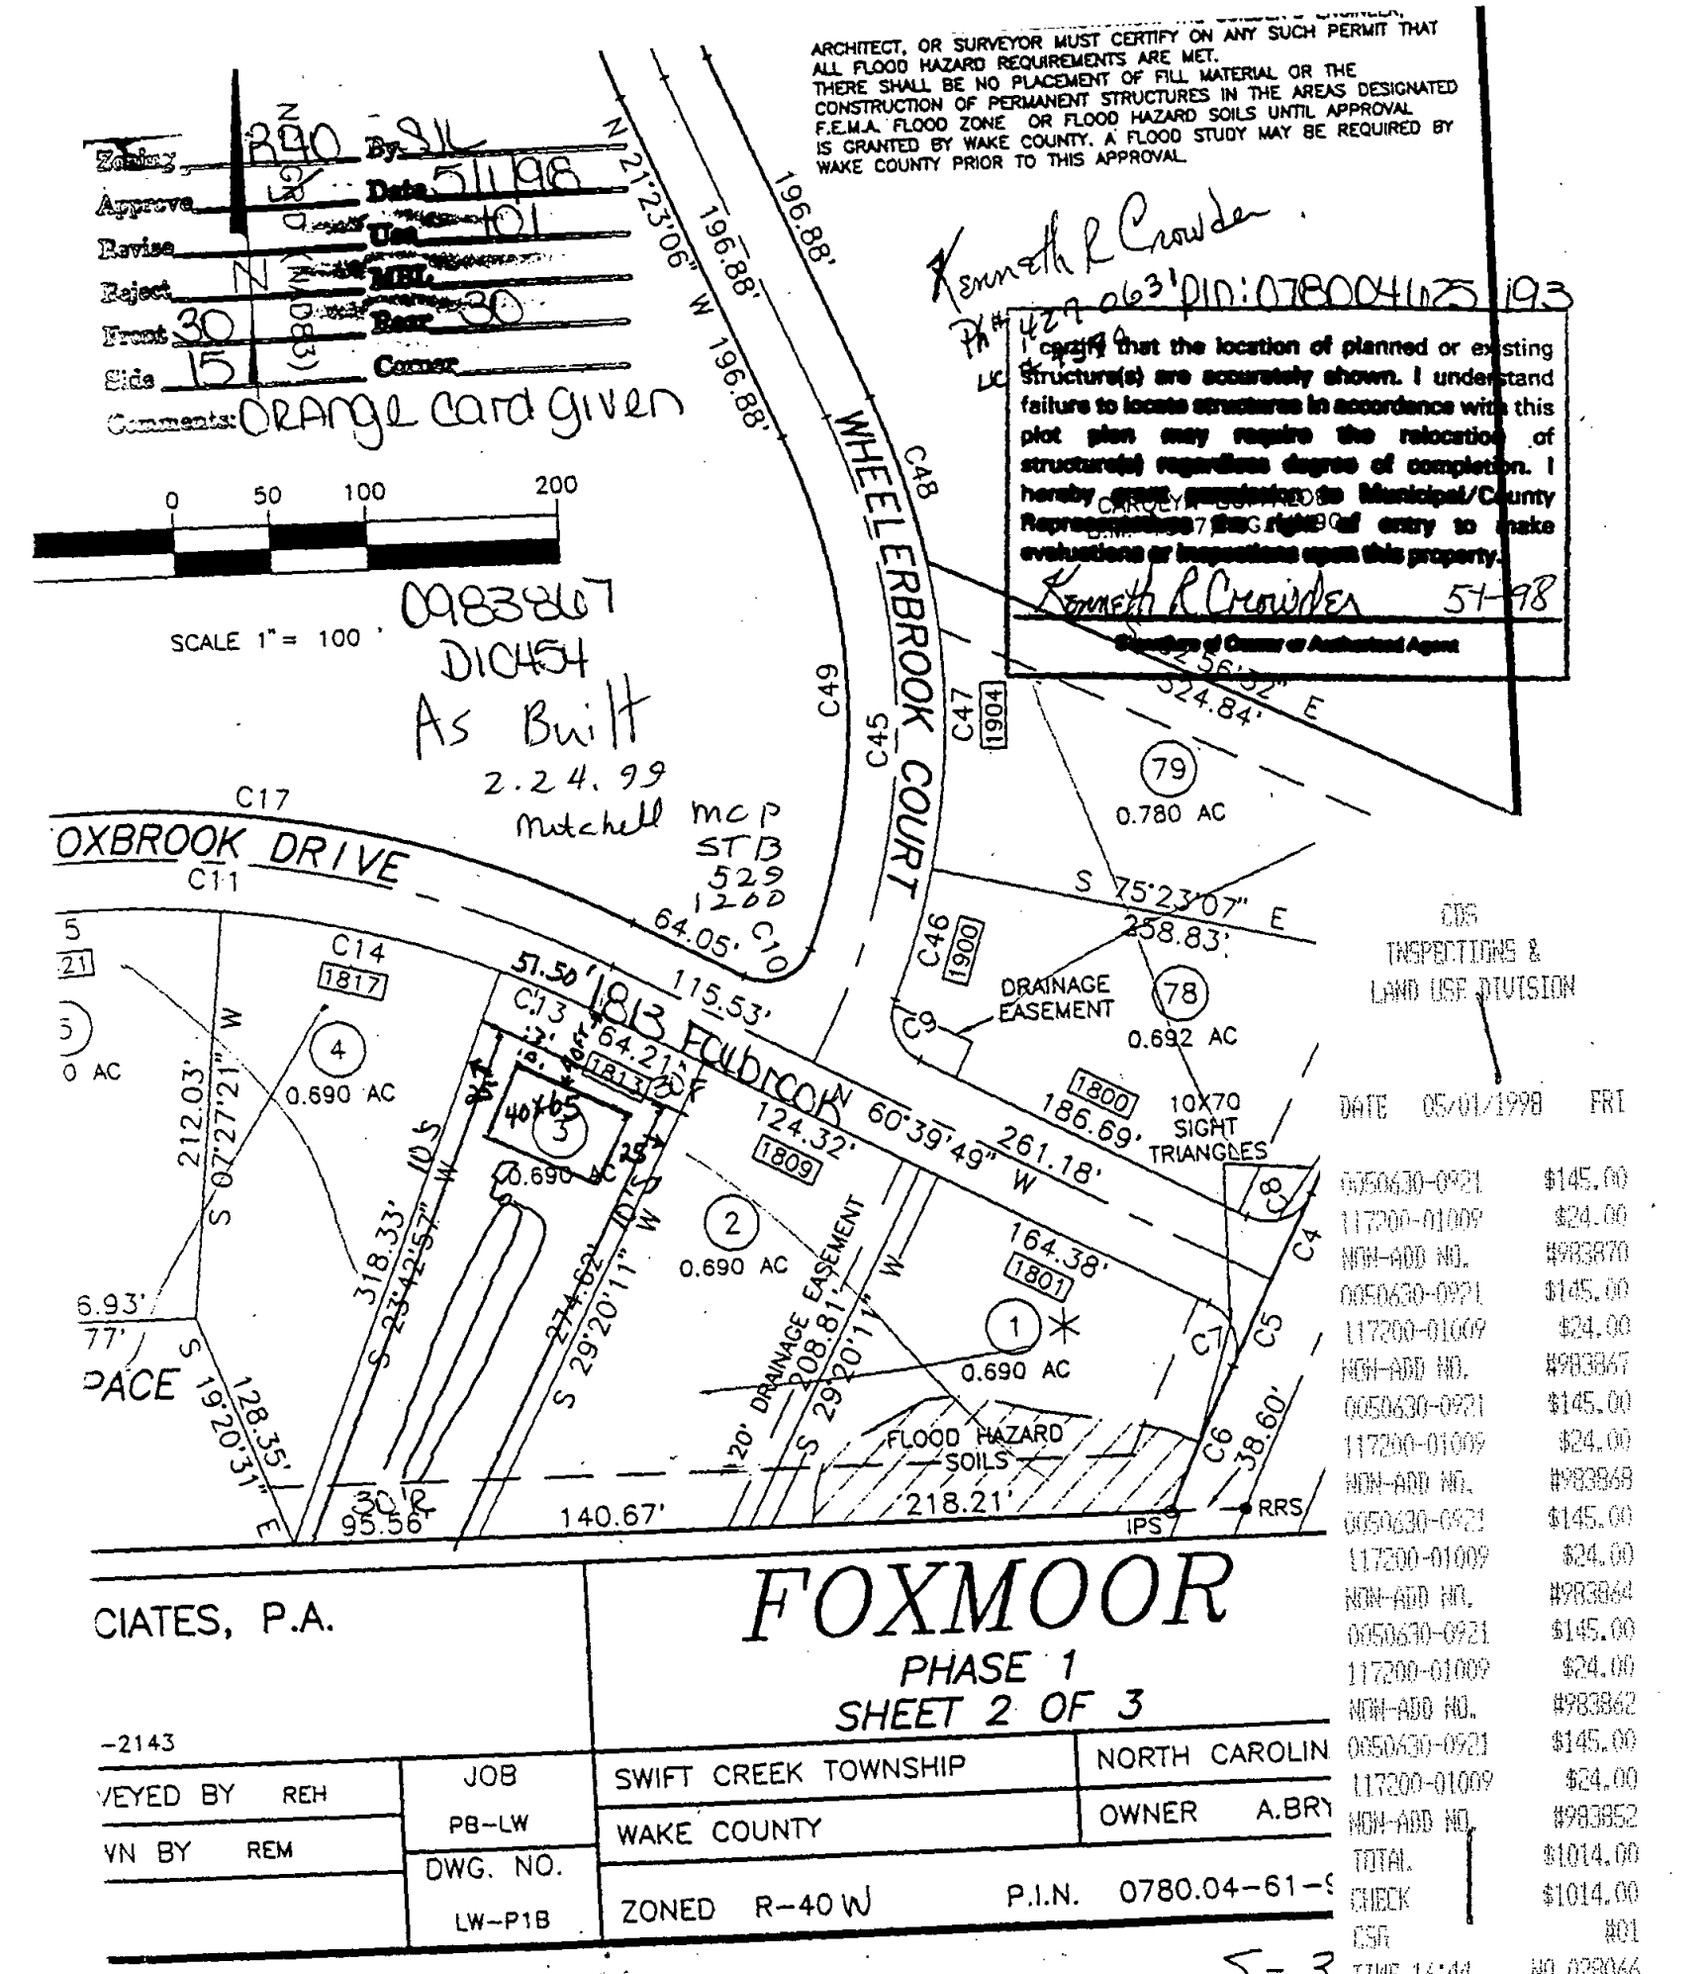

CIATES, P.A.


FOXMOOR

PHASE 1
SHEET 2 OF 3

-2143

VEYED BY REH	JOB	SWIFT CREEK TOWNSHIP	NORTH CAROLIN
VN BY REM	P8-LW	WAKE COUNTY	OWNER A.BRY
	DWG. NO. LW-P1B	ZONED R-40 W	P.I.N. 0780.04-61-9

5-3

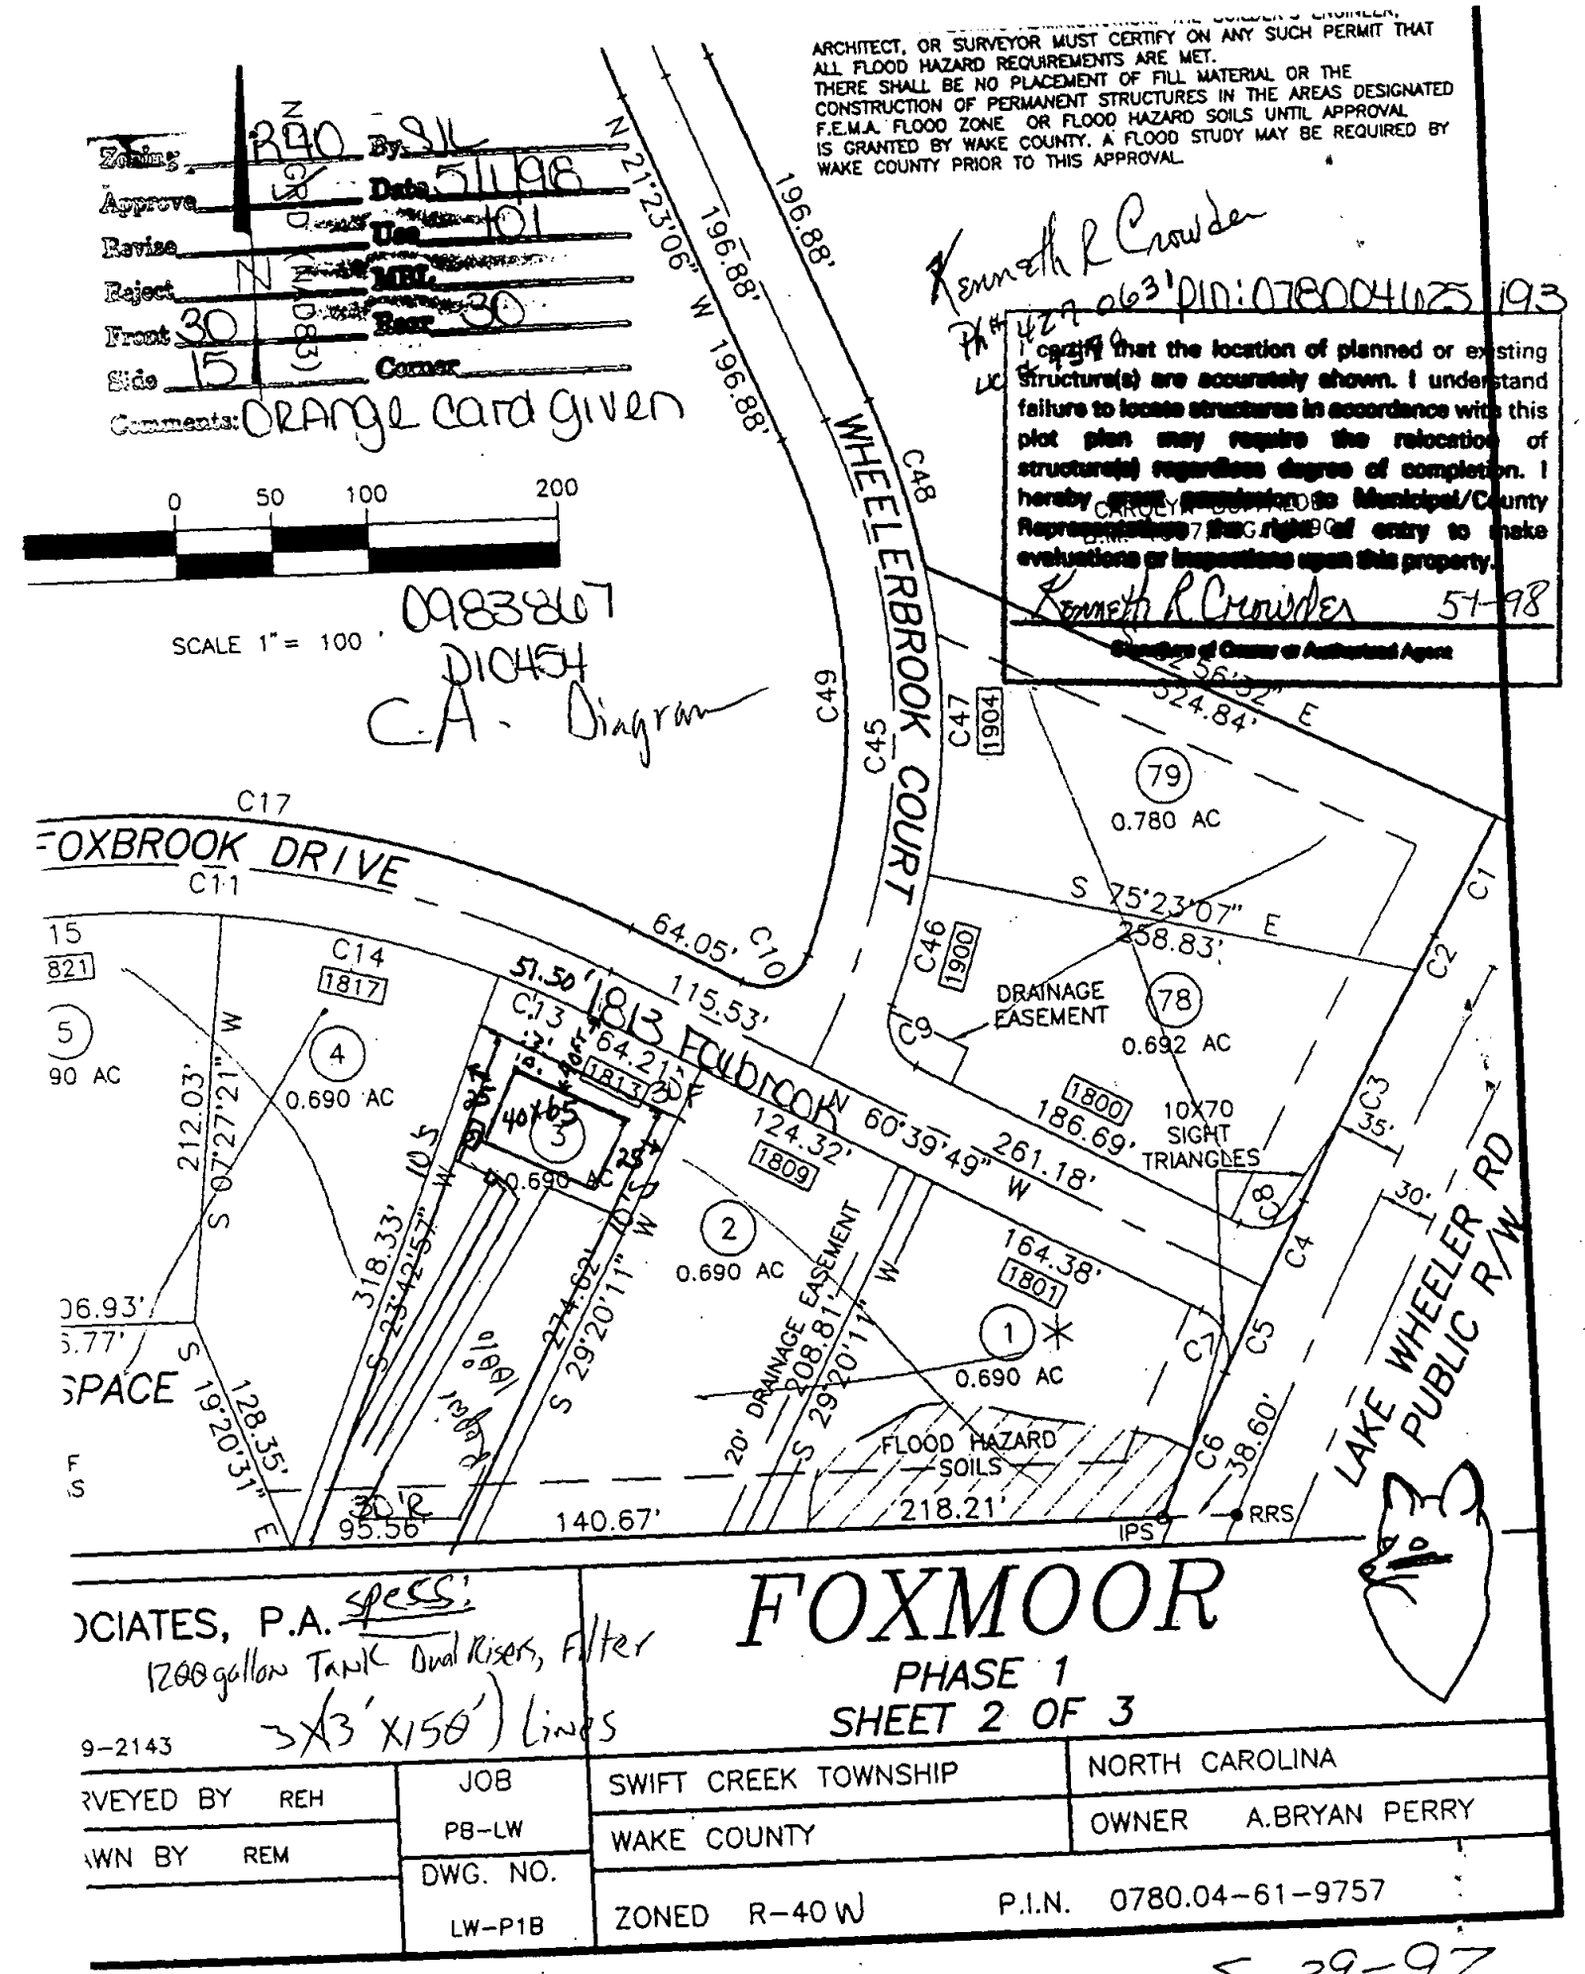
ARCHITECT, OR SURVEYOR MUST CERTIFY ON ANY SUCH PERMIT THAT ALL FLOOD HAZARD REQUIREMENTS ARE MET.
THERE SHALL BE NO PLACEMENT OF FILL MATERIAL OR THE CONSTRUCTION OF PERMANENT STRUCTURES IN THE AREAS DESIGNATED F.E.M.A. FLOOD ZONE OR FLOOD HAZARD SOILS UNTIL APPROVAL IS GRANTED BY WAKE COUNTY. A FLOOD STUDY MAY BE REQUIRED BY WAKE COUNTY PRIOR TO THIS APPROVAL.
Zoning R40W By SIL
Approve Date 5/1/98
Revise Use 101
Reject MBL
Front 30 Rear 30
Side 15 Corner
Comments: ORANGE card given
Kenneth R Crowder
PH# 422-0631 PIN: 0780041625 193
I certify that the location of planned or existing structure(s) are accurately shown. I understand failure to locate structures in accordance with this plot plan may require the relocation of structure(s) regardless degree of completion. I hereby grant permission to Municipal/County Representatives the right of entry to make evaluations or inspections upon this property.
Kenneth R Crowder 5-1-98
Signature of Owner or Authorized Agent
0 50 100 200
SCALE 1" = 100'
0983867
D10454
C.A. Diagram
WHEELERBROOK COURT
FOXBROOK DRIVE
1813 FOXBROOK
LAKE WHEELER RD
PUBLIC R/W
DRAINAGE EASEMENT
FLOOD HAZARD SOILS
10X70 SIGHT TRIANGLES
0.780 AC
0.692 AC
0.690 AC
40x65
N 21°23'06" W 196.88'
S 75°23'07" E 258.83'
N 60°39'49" W 261.18'
S 07°27'21" W 212.03'
S 23°42'57" W 318.33'
S 29°20'11" W 274.62'
S 19°20'31" E 128.35'
S 29°20'11" W 208.81'
64.05'
115.53'
124.32'
164.38'
218.21'
140.67'
95.56'
38.60'
FOXMOOR
PHASE 1
SHEET 2 OF 3
OCIATES, P.A. Specs: 1200 gallon Tank Dual Risers, Filter 3X3'X150') Lines
9-2143
RVEYED BY REH
AWN BY REM
JOB P8-LW
DWG. NO. LW-P1B
SWIFT CREEK TOWNSHIP
WAKE COUNTY
NORTH CAROLINA
OWNER A.BRYAN PERRY
ZONED R-40W
P.I.N. 0780.04-61-9757
5-39-97

LOT 3 SECTION --- BLOCK --- PHASE 1 SUBDIVISION FOXMOOR

AS RECORDED IN MAP BOOK 1998 VOL. --- PAGE 738

OF THE WAKE COUNTY REGISTRY.

I declare that this survey complies with the North Carolina Standards of Practice for Surveying (section . 1600) for class A surveys and that the calculated ratio of precision before adjustments is 10,000+. Furthermore, building corners shown are primary control monumentation for the reestablishment of property corners in the absence of grid monuments and other subdivision property corners. This survey is not to be recorded without the written authorization of the surveyor. This map remains the property of the surveyor and is to be used only for conveyance of this lot to the person(s) shown on this map.

_____, Professional Land Surveyor


Notes: 1) North arrow is referenced to recorded document shown above unless denoted otherwise.
2) House ties are radial to property lines unless shown otherwise.
3) Underground pipes not located with this survey.
4) All areas are computed by coordinates.
5) Flood plain statement attached separately.

LEGEND:

O = EXISTING IRON PIPE
● = NEW IRON PIPE
P = PORCH, S = STOOP, SH = SHED
-x-x- = FENCE, R = RADIUS
—··—·— = CREEK (APPROX. LOCATION)
-E- = OVERHEAD ELECTRIC LINE
LP = LIGHT POLE, PP = POWER POLE
CP = CARPORT, PK = MASONRY NAIL
PL = PROPERTY LINE, MH = MANHOLE
PM = PRELIMINARY MAP
LBS = LOCATION BY SCALE
CL = CHAINLINK, WD = WOOD
C = CHIMNEY, ■ = ELECT. TRANSFORMER
= RECORDED BUILDING ENVELOPE
L = ARC LENGTH, CH = CHORD LENGTH
YI = YARD INLET
DECK, FH = FIRE HYDRANT
NOW OR FORMERLY
DU = DESTINATION UNKNOWN

Site plan approved as shown for SCREEN DECK
Any changes to site plan voids approval. All setbacks apply for septic systems and wells, regarding any pools, decks, additions and/or accessory structures. Applicant is responsible for protecting all portions of the septic system, repair area and wells from damage during construction. Adhere to all Local and State Rules.
Approved by _____ **Date** 6/11/08
Wake County Department of Environmental Services, Water and Waste Water Section

house 1,350
driveway 1,025
2,375
porch 216
Total 2,591
30,056
8.62%

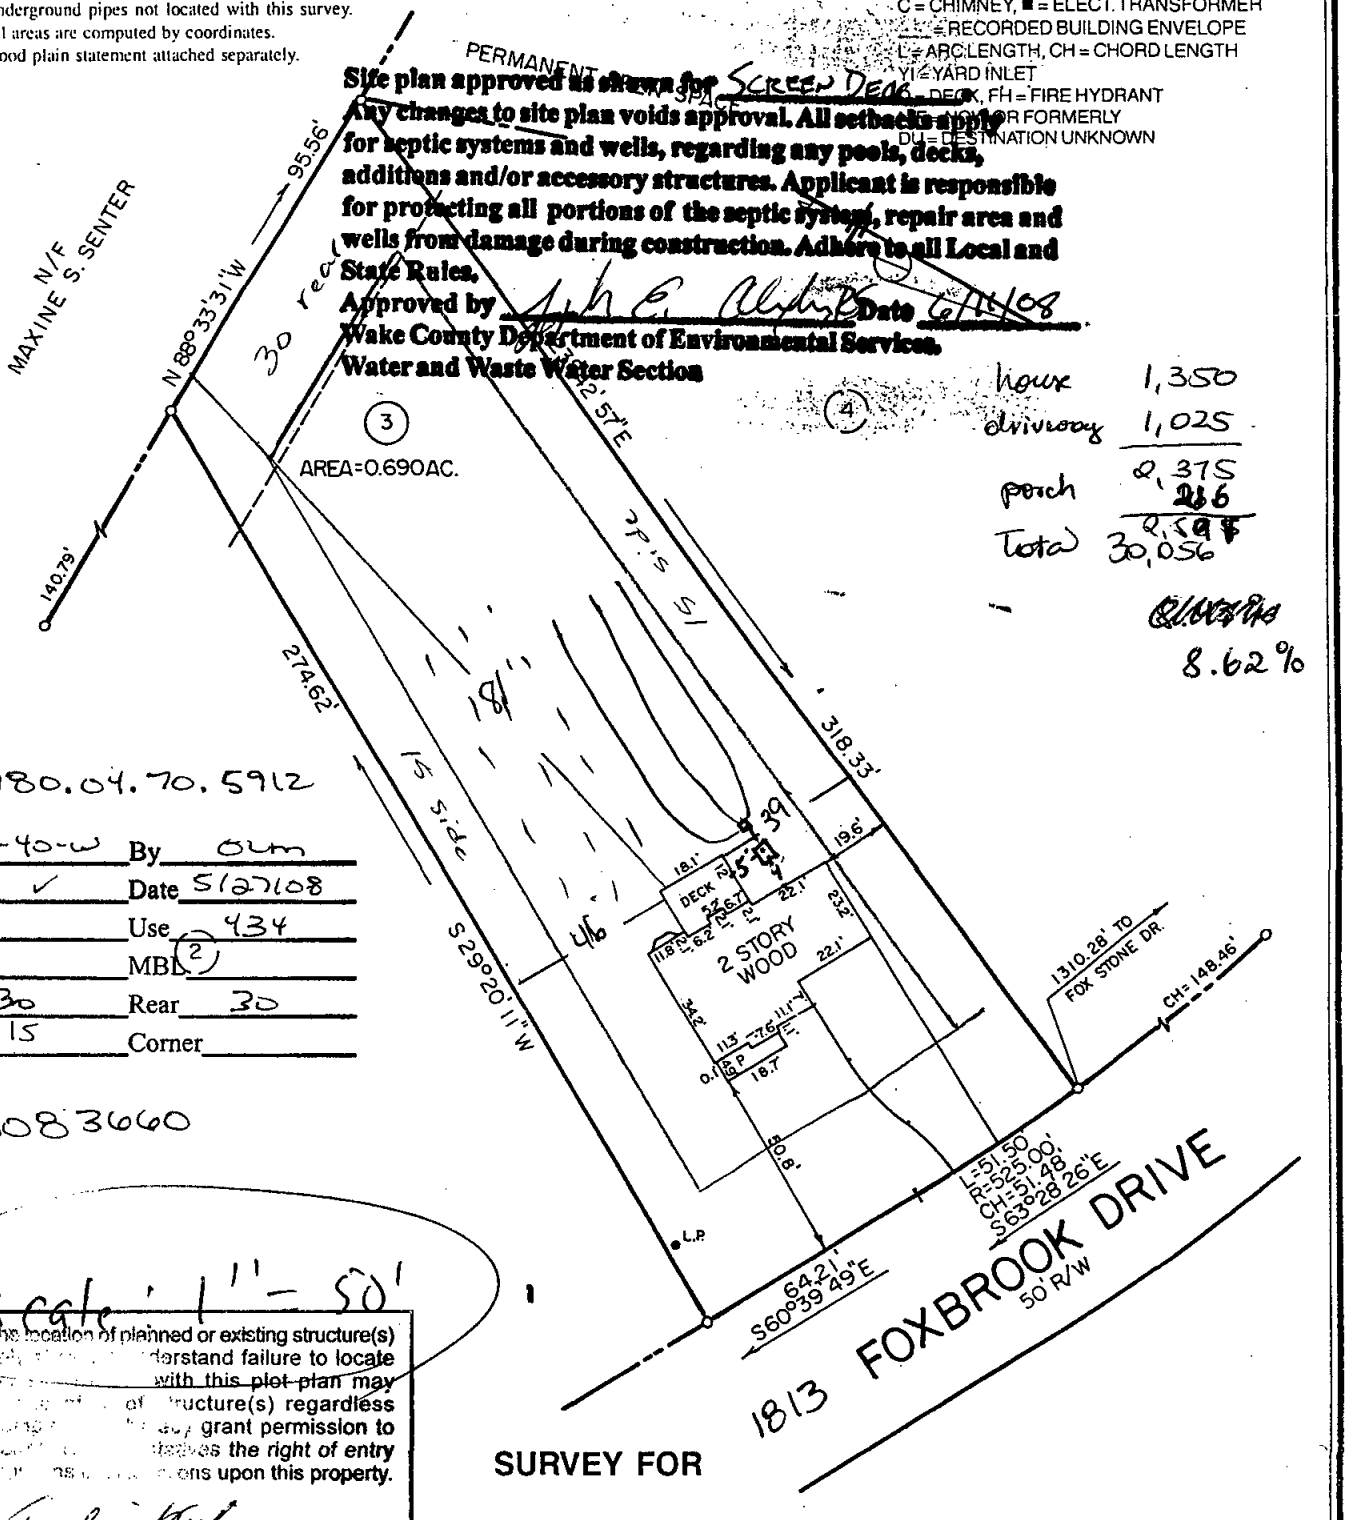

pin-0780.04.70.5912

Zoning R-40-W By OLM
Approve ✓ Date 5/27/08
Revise _____ Use 434
Reject _____ MBL (2)
Front 30 Rear 30
Side 15 Corner _____
Comments:
P-00836060

Scale: 1" = 50'

I certify that the location of planned or existing structure(s) are acc... derstand failure to locate structur... with this plot plan may require ... of ...ructure(s) regardless degree o... grant permission to Municipal... ...es the right of entry to make e... ...ons upon this property.

Signature of Owner or Authorized Agent

SURVEY FOR

ALEXANDER WEST
JENNIFER McCARTHY