
NOTE: Make sketch of installation showing location of house, septic tanks, privies, water supplies on adjacent property, etc. Write in measurements in order that installations may be located at later date.

*No well

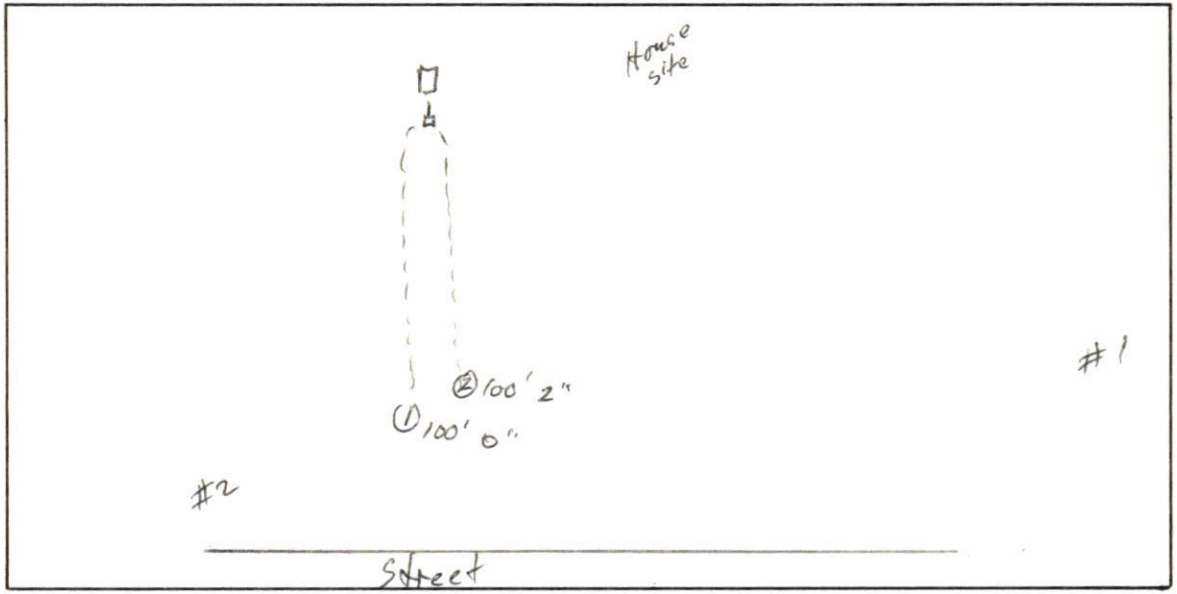

GRANVILLE-VANCE HEALTH DEPARTMENT—Sewage Disposal Record

#475-G

Owner or Contractor Doug Ellis Date 12-10-93 S.R. No. 1625

Location/Address Royal Oak Dr. — Franklinton, N.C.

Subdivision/Mobile Home Park Name Big Oak Farms Lot Size 2Ac+

Lot No. 22-A Site #2

New System ✓ Repair

House Mobile Home ✓ Business

No. Bedrooms 2 No. People 2 No. Toilets

Water Supply: Private ✓ Approved

Semi-Public Unapproved

Public None

Nitrification System:

Tank Size 900 gal.

Distribution Box yes No. Lines 2

Nitrification Field 300'-600 Sq. Ft.

Lines:	1	2	3	4	5	6
Width	3'	3'				
Length	100'	100'				
Grade	0"	2"				
Stone Depth	12"	12"				


Layout to be followed by installer:

Improvements Permit By James C. Parrott Installer Phillip & Robert Blackley

Certificate of Completion By James C. Parrott Date of Inspection 1-26-94

* Construction must comply with all other applicable state and local regulations, but the permit is not a guarantee that the system will not malfunction and the Granville-Vance Health District will not be held responsible for a malfunctioning system.

NOTE: Make sketch of installation showing location of house, septic tanks, privies, water supplies on adjacent property, etc. Write in measurements in order that installations may be located at later date.

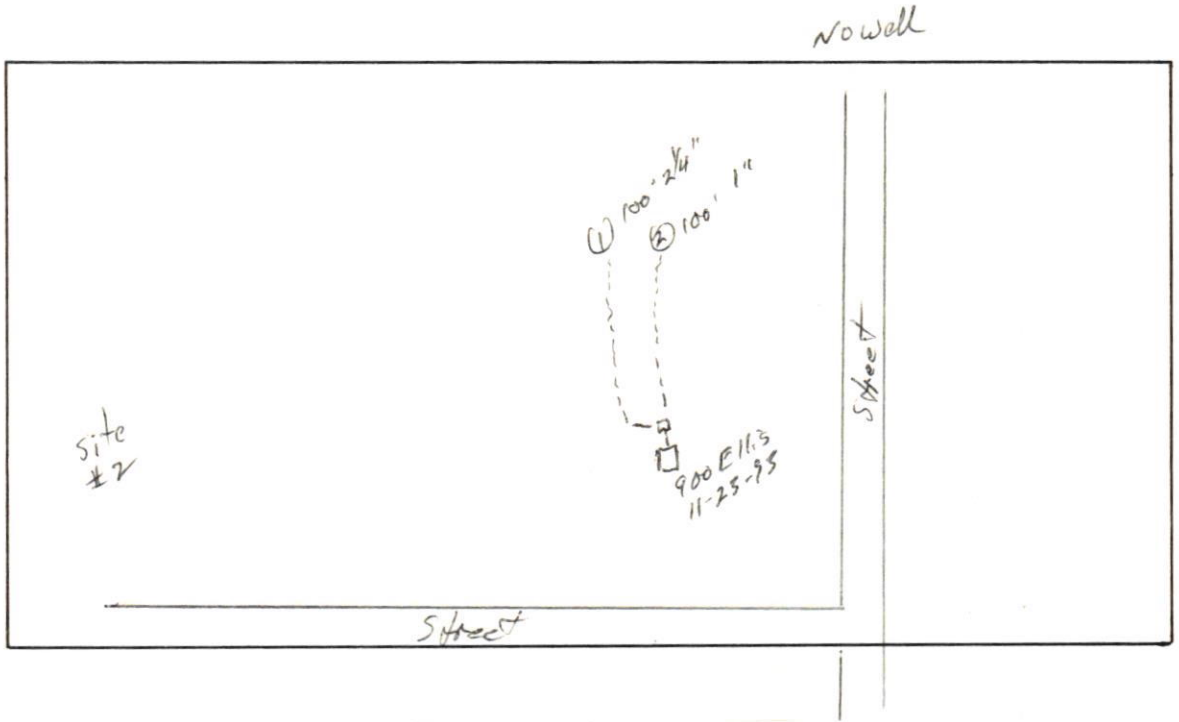

4746

GRANVILLE-VANCE HEALTH DEPARTMENT—Sewage Disposal Record

Owner or Contractor Doug Ellis Date 12-10-93 S.R. No. 1625

Location/Address Royal Oak Dr. — Franklinton, NC

Subdivision/Mobile Home Park Name Big Oak Farms Lot Size 2 Ac+

Lot No. 22-A site #1

New System ✓ Repair

House Mobile Home ✓ Business

No. Bedrooms 3 No. People 4 No. Toilets

Water Supply: Private ✓ Approved

Semi-Public Unapproved

Public None

Nitrification System:

Tank Size 900 gal.

Distribution Box yes No. Lines

Nitrification Field 200' - 600 Sq. Ft.

Lines:	1	2	3	4	5	6
Width	3'	3'				
Length	100'	100'				
Grade	2½"	1"				
Stone Depth	12"	12"				

Layout to be followed by installer:

Improvements Permit By James C. Parrott Installer Phillips + Robert Barkley

Certificate of Completion By James C. Parrott Date of Inspection 1-26-94

* Construction must comply with all other applicable state and local regulations, but the permit is not a guarantee that the system will not malfunction and the Granville-Vance Health District will not be held responsible for a malfunctioning system.