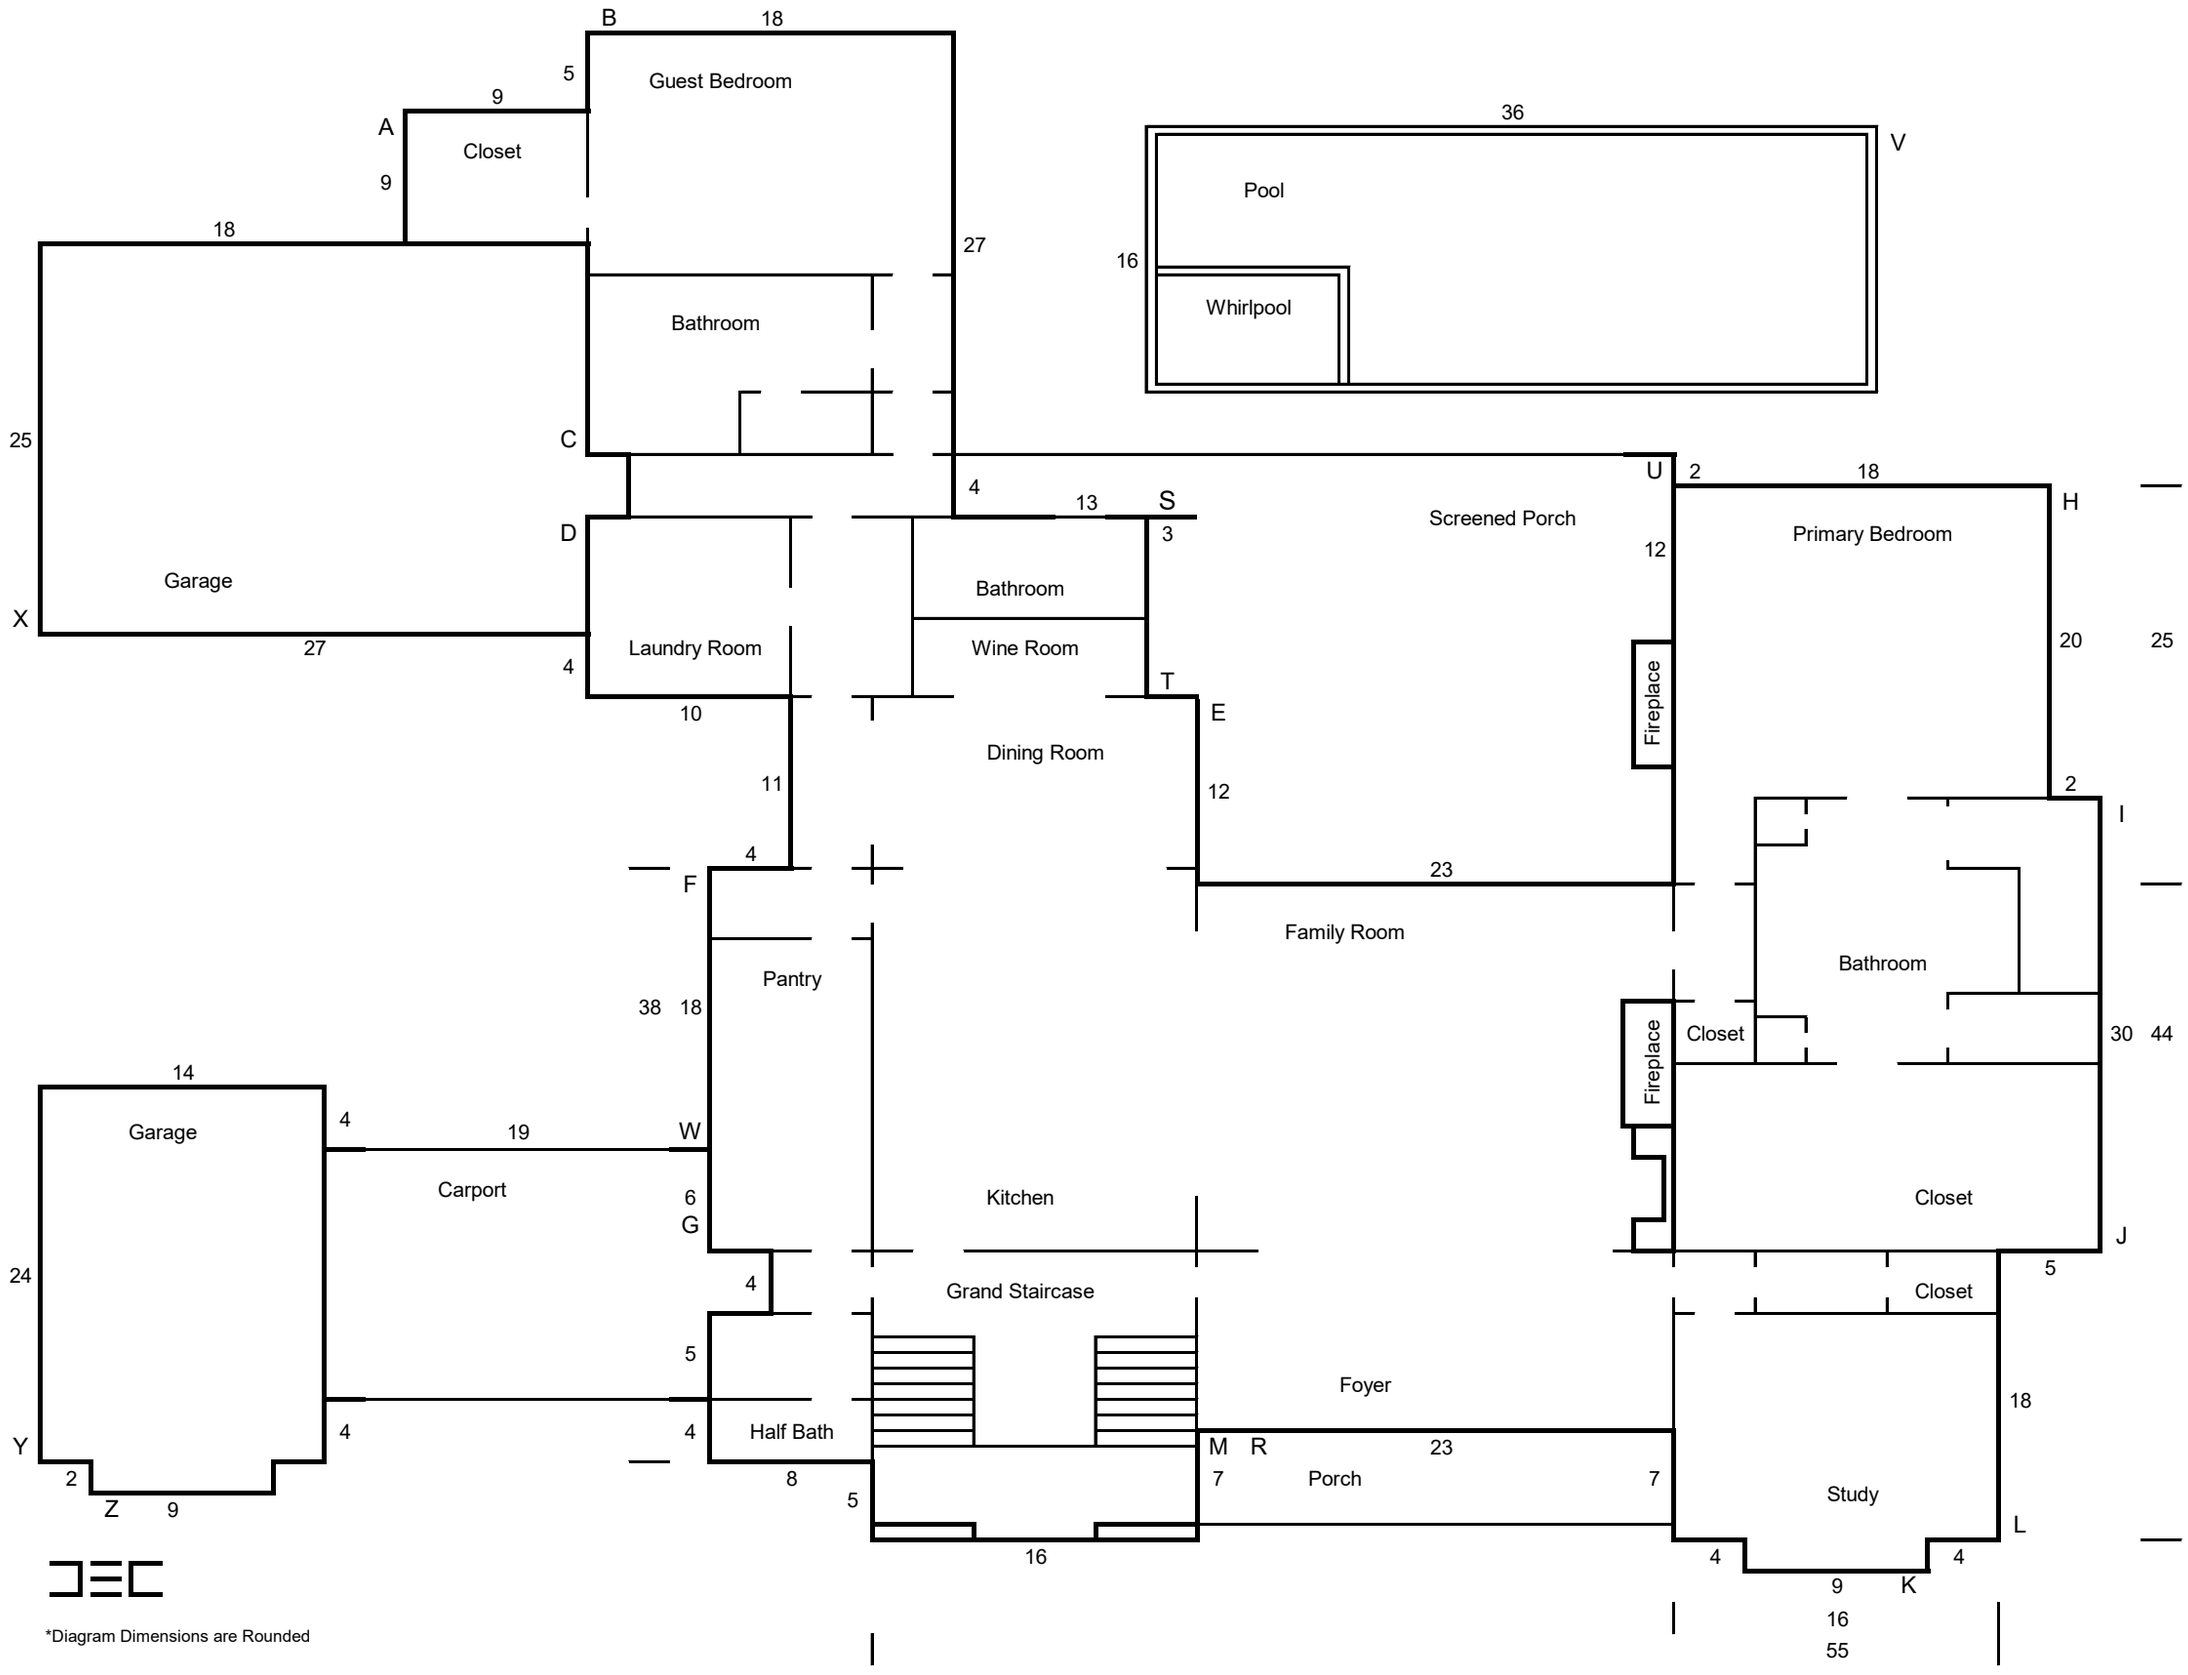


*Diagram Dimensions are Rounded

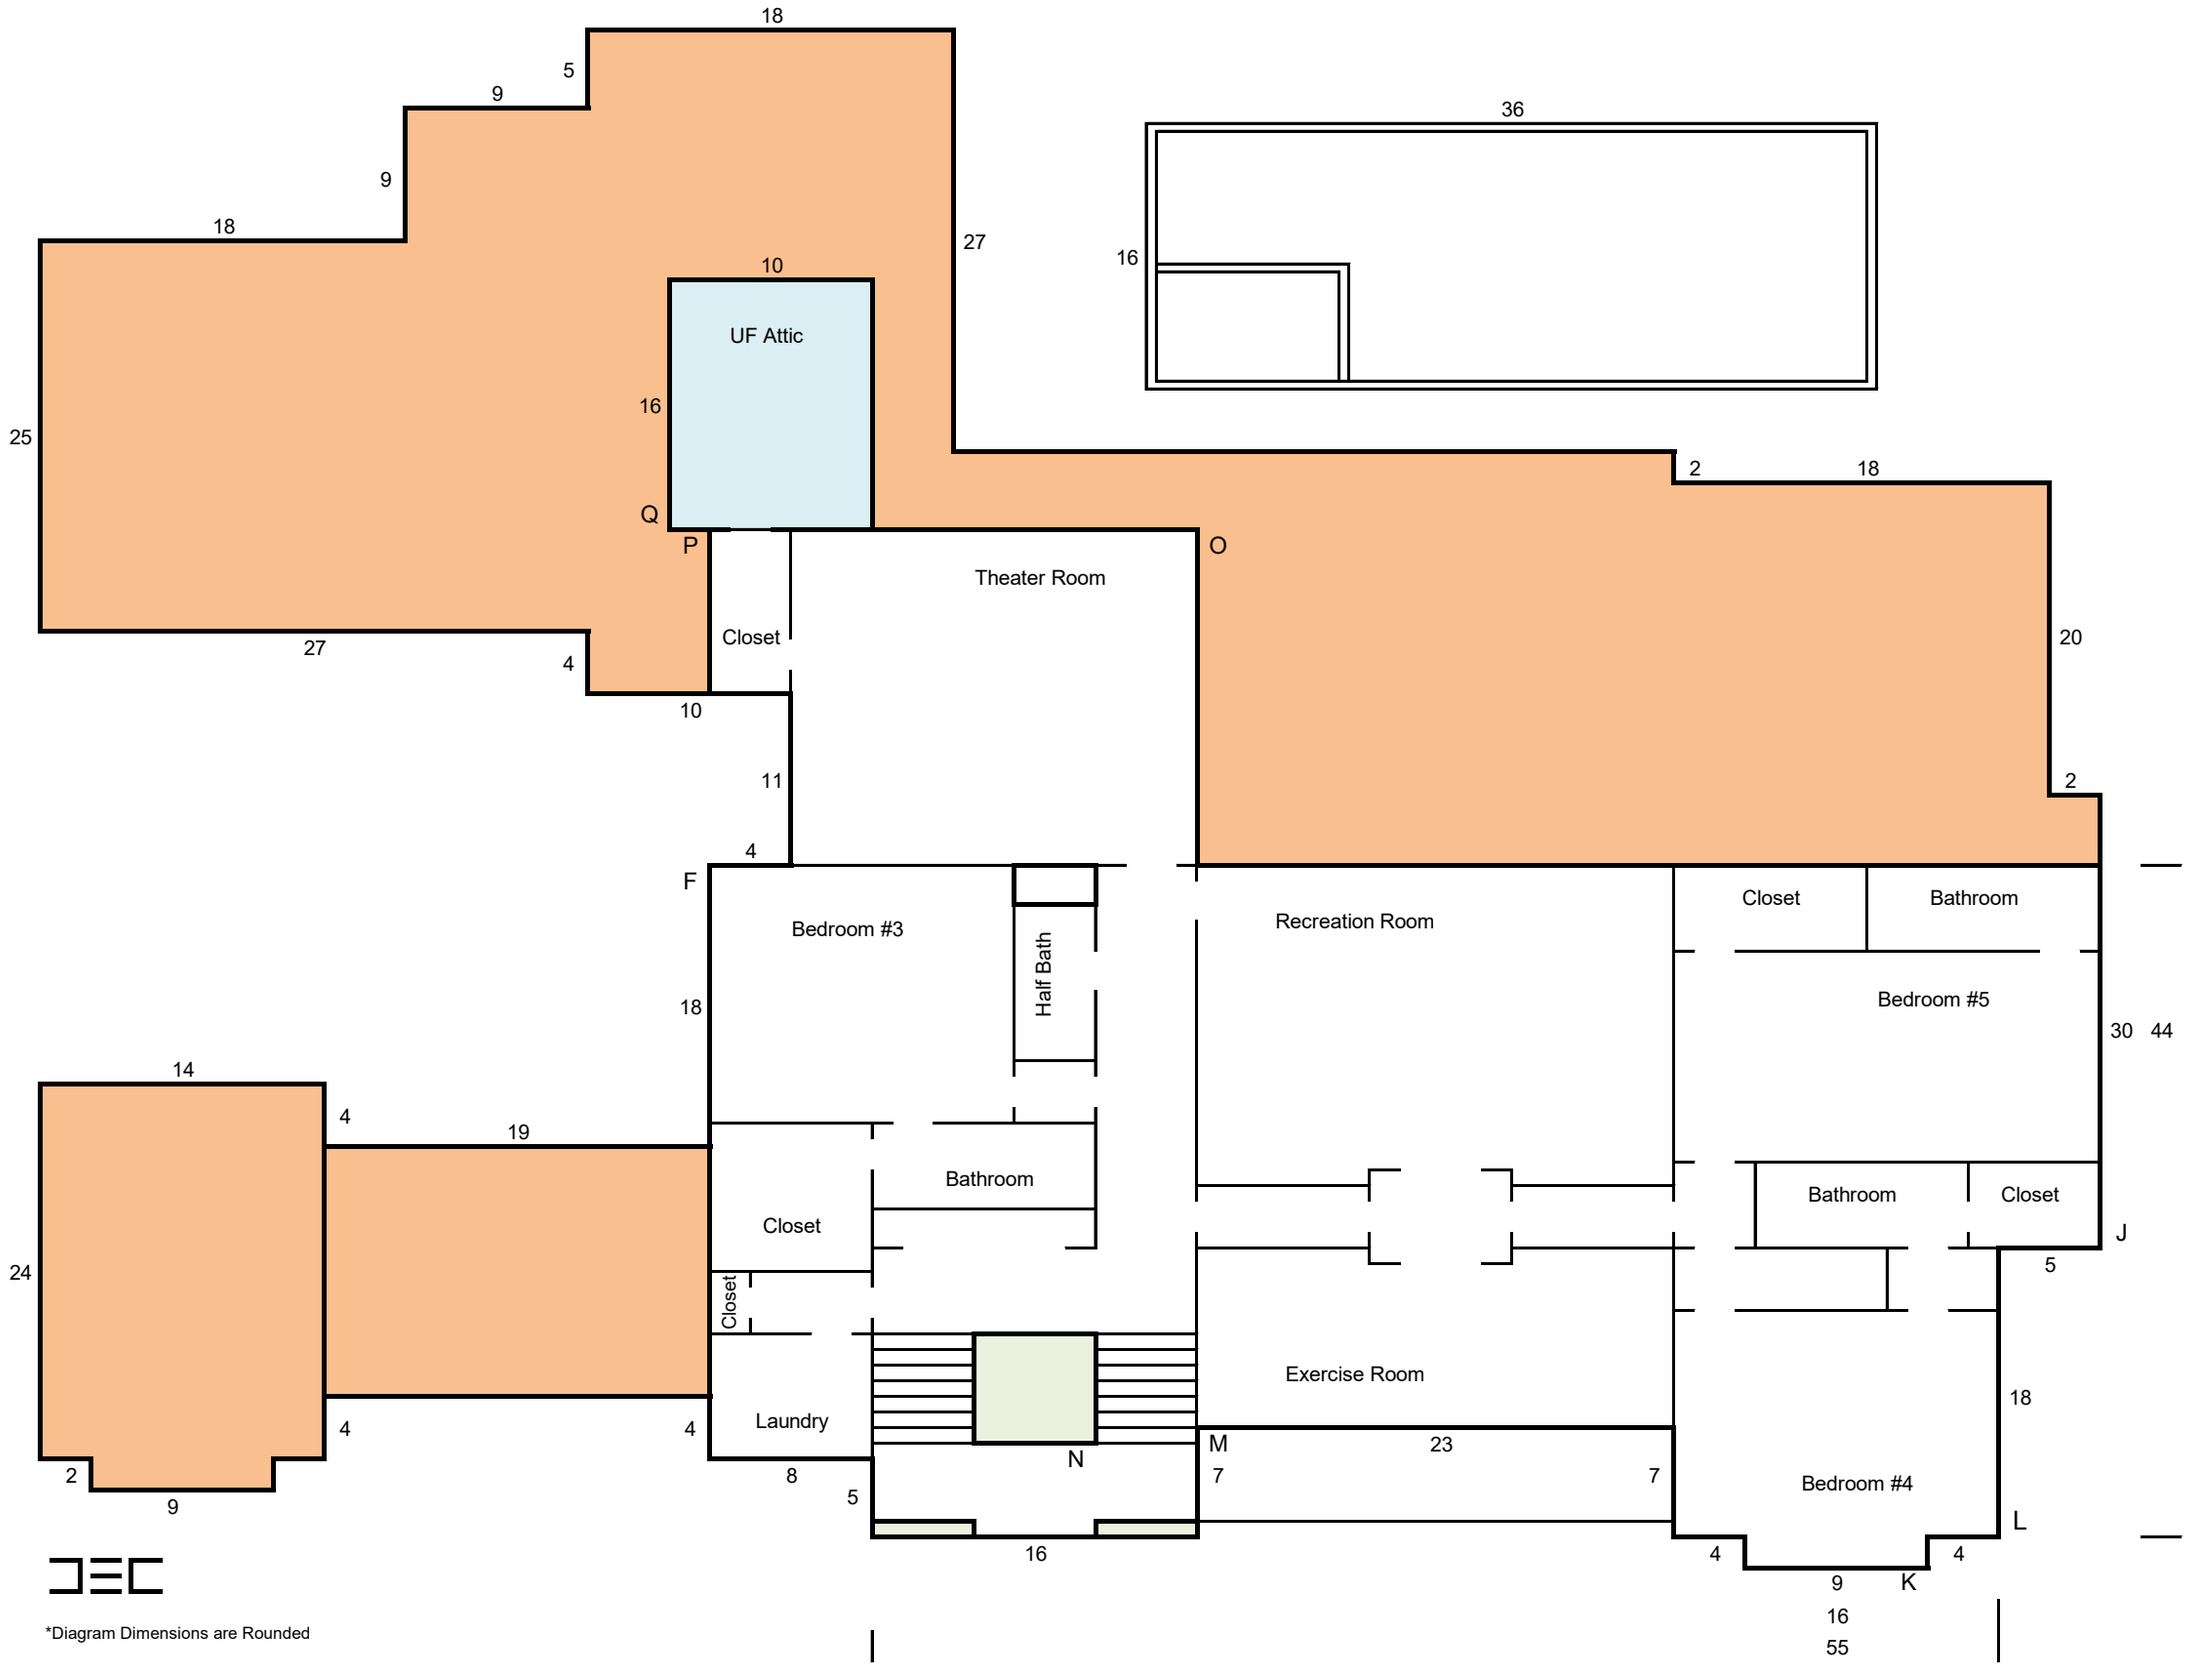


*Diagram Dimensions are Rounded

M	Foyer	22.50 X 10.75
M	Closet	5.41 X 3.91
M	Study	15.33 X 15.08
M	Family Room	23.41 X 22.75
M	Dining Room	14.67 X 10.91
M	Wine Room	10.00 X 3.50
M	Kitchen	24.41 X 15.16
M	Pantry	15.08 X 7.83
M	Laundry Room	9.58 X 9.25
M	Half Bath	7.91 X 7.83
M	Hallway Closet	4.00 X 3.91
M	Primary Bedroom	19.50 X 17.41
M	Primary Bathroom	16.83 X 15.25
M	Primary Closet	19.67 X 11.08
M	Guest Bedroom	15.08 X 7.83
M	Guest Bathroom	12.16 X 11.00
M	Guest Closet	8.00 X 8.00
M	Grand Staircase	17.00 X 15.16
M	Pool Bathroom	10.00 X 5.83
M	Porch	22.50 X 6.00
M	Screened Porch	26.41 X 22.50
M	Pool Patio	
M	Pool	36.00 X 16.00
M	Whirlpool	9.16 X 7.00
M	Carport	18.75 X 16.08
M	Garage	14.24 X 12.91
M	Garage	26.08 X 24.00
2nd	Laundry Room	8.08 X 7.75
2nd	Hallway Closet	4.00 X 2.41
2nd	Theater Room	21.75 X 19.50
2nd	Closet	9.75 X 4.00
2nd	Unfinished Floored Attic	15.83 X 9.75
2nd	Half Bath	8.33 X 3.75
2nd	Bonus Room	22.75 X 19.67
2nd	Exercise Room	22.75 X 11.00
2nd	Bedroom #3	15.08 X 13.58
2nd	Bedroom #3 Bathroom	10.25 X 6.00
2nd	Bedroom #3 Closet	8.58 X 7.25
2nd	Bedroom #4	15.41 X 15.08
2nd	Bedroom #4 Bathroom	9.33 X 5.33
2nd	Bedroom #4 Closet	5.75 X 5.33
2nd	Bedroom #5	19.67 X 12.41
2nd	Bedroom #5 Bathroom	10.16 X 5.41
2nd	Bedroom #5 Closet	9.00 X 5.41

A		8.58 X 8.50 =	72.93
B		31.33 X 17.67 =	553.60
C	n	3.91 X 2.00 =	-7.82
D		28.25 X 10.33 =	291.82
E		28.25 X 11.83 =	334.20
F		38.16 X 8.25 =	314.82
G	n	3.83 X 2.67 =	-10.23
H		25.50 X 18.00 =	459.00
I		4.50 X 2.41 =	10.85
J		25.25 X 4.67 =	117.92
K		9.41 X 2.00 =	18.82
L		55.33 X 43.67 =	2416.26
M	n	22.50 X 7.00 =	-157.50
Total Main Level Finished			4414.67
F		38.16 X 8.25 =	314.82
J		25.25 X 4.67 =	117.92
K		9.41 X 2.00 =	18.82
L		55.33 X 43.67 =	2416.26
M	n	22.50 X 7.00 =	-157.50
N	n	7.33 X 5.58 =	-40.90
O		22.25 X 20.50 =	456.13
P		10.25 X 5.00 =	51.25
Total 2nd Level Finished			3176.79
Total Heated & Finished			7591.46
Q		15.83 X 9.75 =	154.34
Total Unfinished Floored Attic			154.34
R		22.50 X 6.00 =	135.00
Total Porch			135.00
S		13.16 X 4.25 =	78.96
T		10.33 X 2.58 =	26.65
U		26.41 X 22.50 =	594.23
Total Screened Porch			699.84
V		36.00 X 16.00 =	576.00
Total Pool			576.00
W		18.75 x 16.08 =	301.50
Total Carport			301.50
C		3.91 X 2.00 =	7.82
X		26.75 X 25.16 =	673.03
Y		23.50 X 14.16 =	332.76
Z		9.33 X 2.00 =	18.66
Total Garages			1032.27