Franklin County
NORTH CAROLINA

File # 394306 PIN# _____

Property Address: 422 Shawnee Dr

Applicant or Owner Name: Kelly Kolbe

Environmental Health Septic/Well Permit Diagram

Building permits cannot be issued nor should construction begin without Construction Authorization issuance.

◯ Septic Improvement Permit ⊗ Septic Construction Authorization (CA) ◯ CA Reissue** ◯ As Built

◯ Well Construction Authorization ◯ Additional Diagram/Specifications Attached

Diagram Date:** 6/6/23 **EHS:** [illegible]

****Any previously dated CA diagram is revoked and/or invalid. Confirm this is the valid diagram for the site before beginning any construction.**

Installation/grouting inspections may be scheduled the day before, or, the day of installation until 9am by contacting the Environmental Health office at 919 496 8100. A revisit fee may apply if installation is not ready for inspection at the time requested. ***Septic Operations Permits*** will be issued after installation is approved, all permits conditions are met, and any outstanding fees are paid. ***Well Certificate of Completion*** will be issued after well head approval, all permit conditions are met, and any outstanding fees are paid.

Septic Tank _____ Pump Tank _____ Drainfield _____ Type System_____ Max Trench Depth_____

Septic Contractor _____ Septic/Pump tank dates_____ Pump fee? Yes No


Well Contractor _____ Well Grout date:_____

scale: Not to Scale

Add pump chamber & related items, 6 x 50' drainline to accomodate 1 bedroom addition in home

Parking area must be abandoned to install new drainline

- location of pump tank may vary

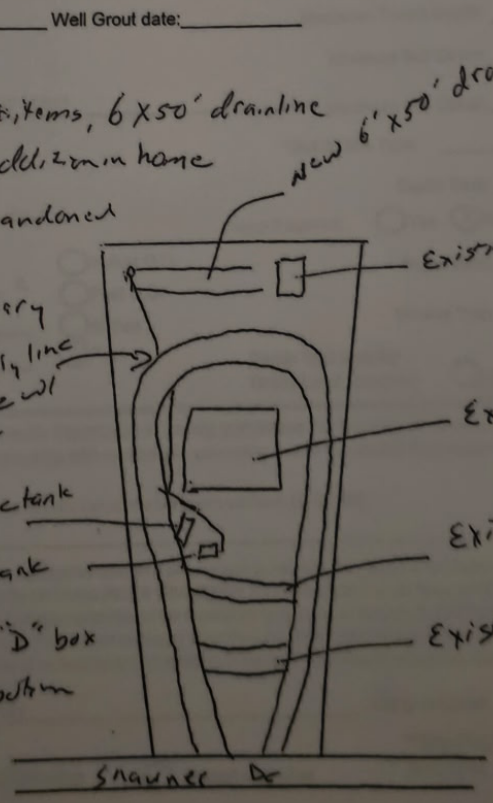

* Feed pump tank from "D" box to have equal distr. bottom of each drainline

FCEH FORM 165 9/19, 10/19