Environmental Services - Water Quality
Onsite Wastewater Scan Data Entry Form

PERMIT #: B 0 3 5 7 8 7 PIN #: 0 6 5 9 8 7 9 8 9 8

OP DATE: 0 9 1 0 9 1 1 9 8 6

SYSTEM USE:
- ☐ House
- ☒ Mobile Home
- ☐ Business
- ☐ Other

SEWAGE TYPE:
- ☒ Domestic
- ☐ Industrial

PUMP/SIPHON?:
- ☐ Yes
- ☒ No

PRESSURE MANIFOLD:
- ☐ Yes
- ☒ No

SYSTEM TYPE:
- ☐ I
- ☒ II
- ☐ III
- ☐ IV
- ☐ V
- ☐ VI
- ☐ Other

SUB TYPE:
- ☒ A
- ☐ B
- ☐ C
- ☐ D
- ☐ E
- ☐ F
- ☐ G

NBR BEDROOMS:
- ☐ 1
- ☐ 2
- ☒ 3
- ☐ 4
- ☐ 5
- ☐ 6
- ☐ Other

MAINT. SCHEDULE:
- ☐ Yes
- ☒ No

CERT. OPERATOR
- ☐ Yes
- ☒ No

GT	ST	PT	SIZE
☐	☐		750
☐	☐	☐	900
☐	☒	☐	1,000
☐	☐	☐	1,200
☐	☐	☐	1,500
☐	☐	☐	1,800
☐	☐	☐	2,100
☐	☐	☐	2,500
☐	☐	☐	3,000
☐	☐	☐	4,000
☐	☐	☐	5,000
☐	☐	☐	8,000
	☐	☐	10,000
☐	☐	☐	Other
☒		☒	None/NA GT or PT

DRAINFIELD SIZE(SQ. FT.)

0 1 2 0 0

DRAIN TYPE:
- ☒ Stone
- ☐ EZ Flow
- ☐ Infiltrator
- ☐ Biodiffuser
- ☐ Cultec
- ☐ Drip
- ☐ Hancor
- ☐ Large Dia. Pipe
- ☐ Multi-Pipe
- ☐ Other

MAX DEPTH (IN.):
- ☐ 12 in. or less
- ☐ 18 in. or less
- ☒ 24 in. or less
- ☐ 26 in. or less
- ☐ 28 in. or less
- ☐ 30 in. or less
- ☐ 32 in. or less
- ☐ 36 in. or less
- ☐ Other

20" - 24" depth

STONE DEPTH (IN.):
- ☐ 8 in. or less
- ☒ 12 in. or less
- ☐ 18 in. or less
- ☐ 24 in. or less
- ☐ Other

TRENCHES:
- ☒ Individual
- ☐ Bed

TRENCH WIDTH (IN.):
- ☐ 12 in. or less
- ☐ 18 in.
- ☐ 24 in.
- ☒ 36 in.
- ☐ 6 ft. or less
- ☐ 9 ft. or less
- ☐ Other

5/8/15 MJ

WAKE COUNTY HEALTH DEPARTMENT SEPTIC TANK LAYOUT AND PERMIT

35787

TAX MAP NO. 7411 PARCEL NO. 160 & 161 0659879898 PERMIT NO. B

OPERATION PERMIT ☐

CONTRACTOR

OWNER Thaddeus Stasik DATE 8/14/86

LOCATION At end of Maple Drive

S. R. NO. 1301

SUBDIVISION NAME Cassidy Subdivision LOT NO. 73 & 72 SECTION OR BLOCK NO.

REPAIR ☐ ORIGINAL PERMIT NO.

GARBAGE DISPOSAL UNIT YES ☐ NO ☒

HOUSE ☐ MOBILE HOME ☒ BUSINESS ☐

NO. BEDROOMS 3 LOT AREA 40,000±

SIZE OF TANK 1000 gal.

NITRIFICATION LINE 2(3'×21') 1200 sq. ft.

DEPTH OF STONE IN LINES: 12" ☒

RISER AND BAFFLE REQUIRED ☐ PUMP REQUIRED ☐

WATER SUPPY: INDIVIDUAL ☒ PUBLIC ☐ OTHER ☐

* PERMIT VOID 36 MONTHS FROM DATE OF ISSUANCE.
* PERMIT VOID IF NOT IN COMPLIANCE WITH ZONING REGULATIONS
* PERMIT MAY BE VOIDED IF SITE ALTERATIONS MADE

LAYOUT BY Steve Braxton

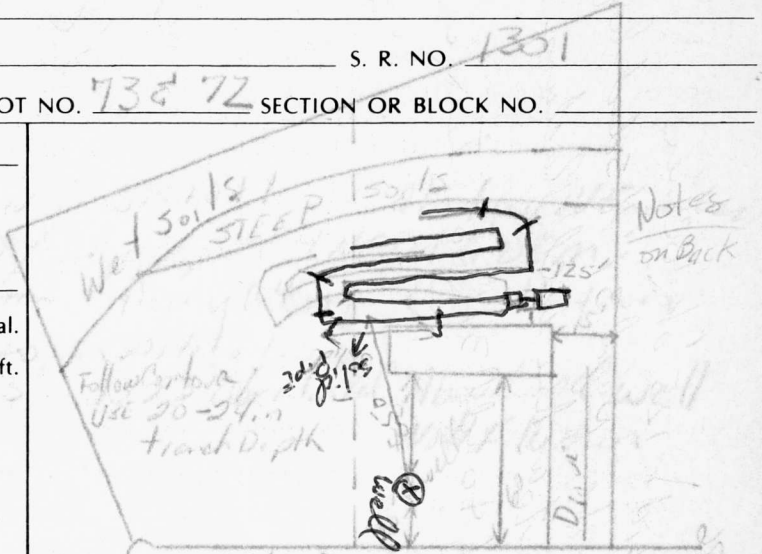

9/9/86	W.A. Jones	Steve Braxton
DATE	INSTALLED BY	APPROVED BY

9/5/86

① Inside 125' ok to Corner

② Outside Need 37' of solid before S.P. to achieve well Radius

③ Need to add 37'Ⓓ to outside