WAKE COUNTY DEPARTMENT OF ENVIRONMENTAL SERVICES WASTEWATER PERMIT

NO PERMIT(S) FOR CONSTRUCTION, LOCATION OR RELOCATION ACTIVITY SHALL BE ISSUED UNTIL AN AUTHORIZATION FOR WASTEWATER SYSTEM CONSTRUCTION AUTHORIZATION HAS BEEN ISSUED

PERMIT VOID IF NOT IN COMPLIANCE WITH ZONING REGULATIONS AND/OR IF SITE IS ALTERED OR INTENDED USE CHANGED

OPERATIONS PERMIT

PERMIT # WREP-097598-2023 **APPLICATION DATE:** 02/21/2023 **BLDG. PERMIT#:**

PIN: 1725627265 **RECORDED:**

TOWNSHIP: 17 - St. Matthews **JURISDICTION:** Raleigh **ZONING:** R-6

APPLICANT: Frank Aguirre
3810 WESTER RD

BUSINESS PHONE:
HOME PHONE: (919) 872-2595
MOBILE PHONE: (919) 612-8703

HD USE: 0001 REPAIR/EXISTING SYSTEM **EXISTING USE:** 101A CONVENTIONAL ONE-FAMILY HOUSE

SITE ADDRESS: 3810 WESTER RD

SUBDIVISION: G W WESTER SUB **LOT:** 30 **ACRES:** 0.53

DIRECTIONS: Take Capital Blvd, Right on Old Trawick Rd, Continue to Trawick Rd, Continue straight onto Marsh Creek Rd, Right on Dove Ln, Right on Wester Rd. Property on Left.

Systems defined as either type III-b, III-g with a pump, IV, V or VI, in accordance with the North Carolina administrative code 15A NCAC 18a .1961, table V as adopted by reference in the "Regulations Governing Wastewater Treatment Dispersal Systems in Wake County", requires Wake County Environmental Services to conduct periodic inspections of the system type pursuant to 15A NCAC 18a. 1961 (j). Fees for these inspections will be charged as per the approved Fee Schedule. In addition, all systems are to be operated and maintained as specified in 15A NCAC 18A .1961. This permit is based in part on information provided by the homeowner and/or his/her representative in the application submitted for this permit. The Environmental Health Specialist is not responsible for false or misleading information contained in the application. The environmental health specialist is also not responsible for concealed conditions on the property or for statements in this report that may have resulted from false or misleading statements provided to him/her in the application. Neither Wake County nor the Environmental Health Specialist warrants that the septic tank system will continue to function satisfactorily in the future or that the water supply will remain potable.

OPERATION PERMIT VALID FOR: No Expiration
INSTALLED BY: HEFLIN, KENNITH D - 4867 - II
PROPRIETARY SYSTEM: EZ1203HG - EZFlow EZ 1203H Geo **PRETREATMENT SYSTEM:**
SYSTEM TYPE INSTALLED: III G
OPERATION PERMIT: STATUS: Issued **ISSUED BY:** Tim Warren **ISSUED DATE:** 05/16/2023

SEPTIC TANK: EXISTING **DATE OF MANUFACTURE:** **FILTER:**
GREASE TRAP: **DATE OF MANUFACTURE:** **FILTER:**
DOSING PUMP TANK: **DATE OF MANUFACTURE:** **FILTER:**
CC1: **ETM1:** **CC2:** **ETM2:**
RECIRCULATION TANK: **DATE OF MANUFACTURE:**
CC1: **ETM1:** **CC2:** **ETM2:**

SEPTIC TANK ELEVATION: **GREASE TRAP ELEVATION:** **DOSING PUMP TANK ELEVATION:**
RECIRCULATION TANK ELEVATION: **DISTRIBUTION DEVICE ELEVATION:** 5

INSTALLED TRENCH DEPTH	INSTALLED AGGREGATE DEPTH	INSTALLED TRENCH LENGTH	INSTALLED TRENCH BOTTOM ELEVATION
18	12	75	6.67
18	12	75	7.8


ACTUAL PRESSURE HEAD: **ACTUAL FLOW RATE:** **ACTUAL DOSE VOLUME:** 0

SPECIFIC OPERATION REQUIREMENTS:

OPERATION PERMIT ISSUED FOR A 2 BEDROOM HOME WITH DAILY FLOW RATE OF 240 GALLONS PER DAY

ISSUED BY: 

DATE: 05/16/2023

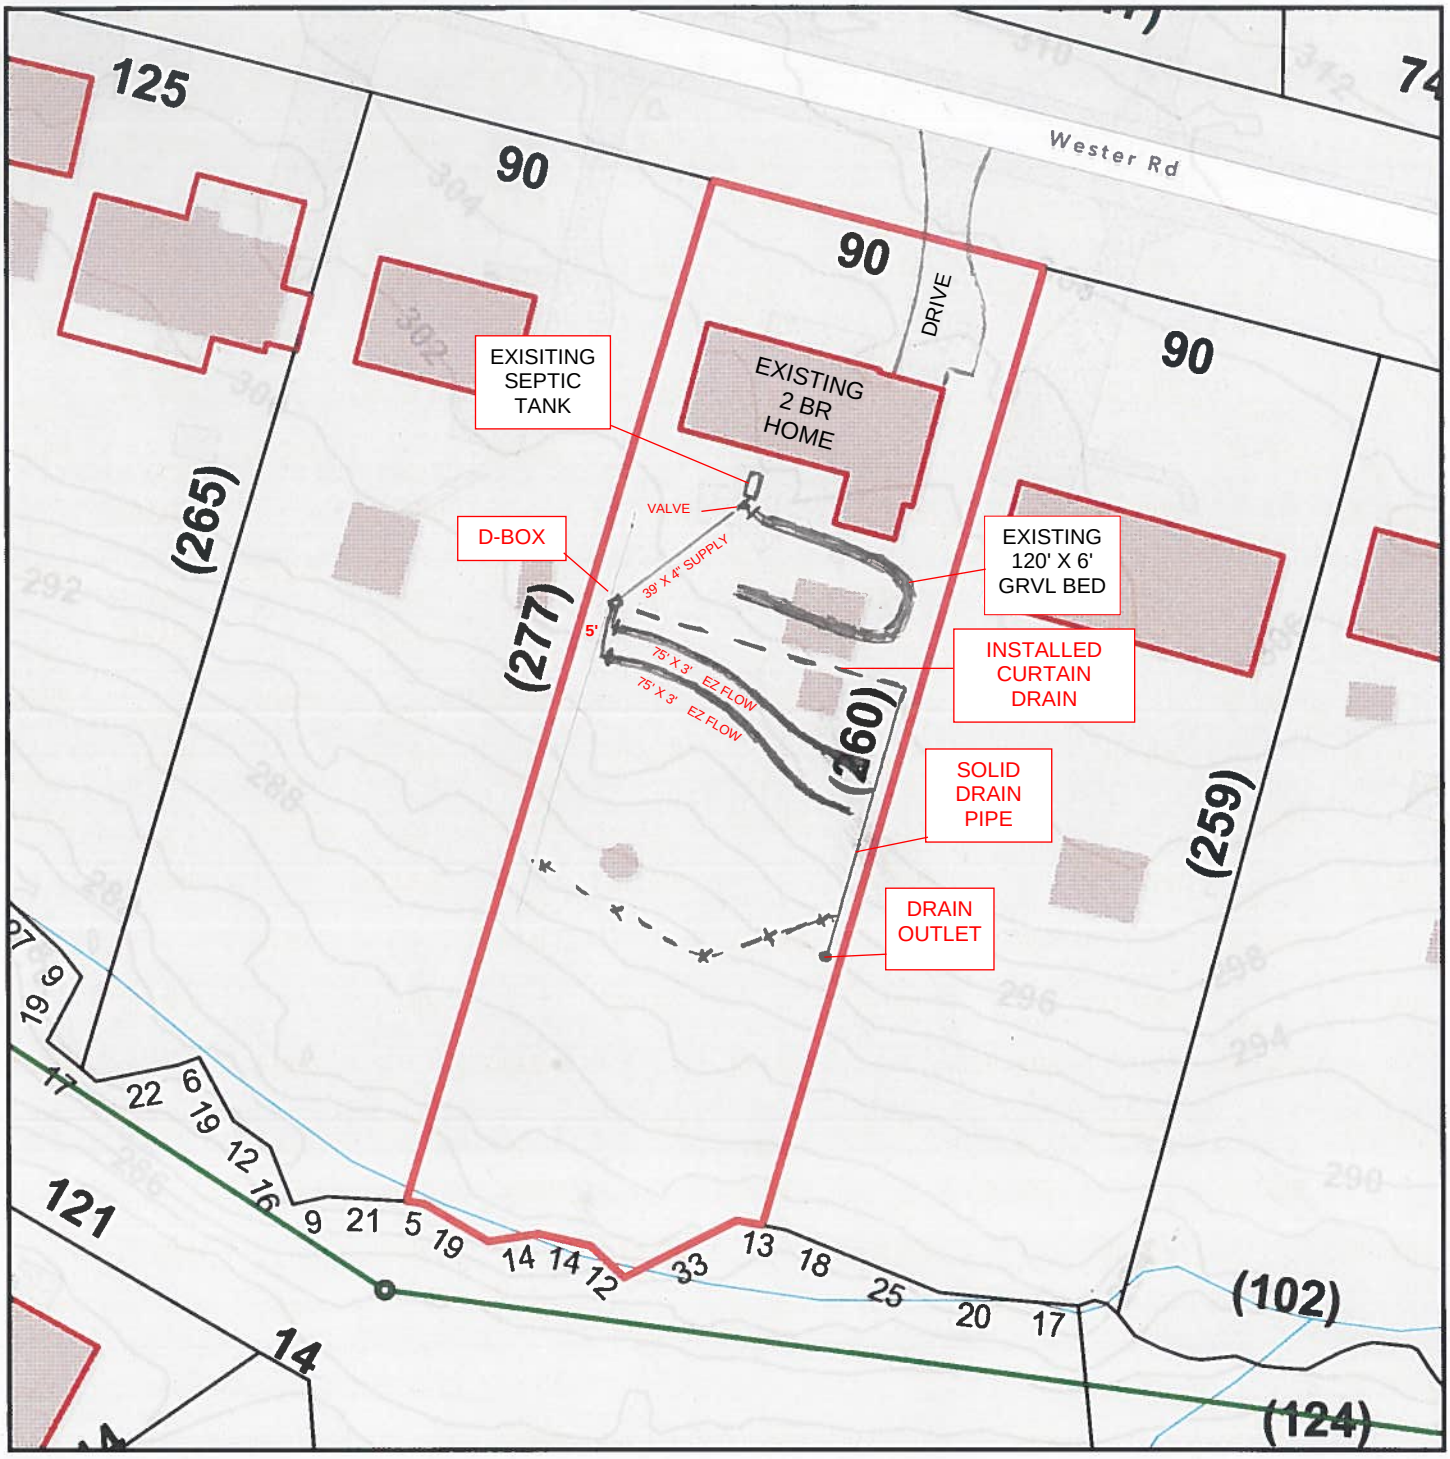

3810 WESTER RD

N

05/16/2023
JTW

0 25 50 100 ft

1 inch equals 50 feet

OPERATION PERMIT

AS BUILT

REPAIR

WREP-097598-2023

Disclaimer
*iMaps makes every effort to produce and publish the most current and accurate information possible. However, the maps are produced for information purposes, and are **NOT** surveys. No warranties, expressed or implied ,are provided for the data therein, its use,or its interpretation.*