PERMIT IS SUBJECT TO REVOCATION IF SITE PLANS OR INTENDED USE CHANGE

WARREN COUNTY HEALTH DEPARTMENT

ENVIRONMENTAL HEALTH DIVISION

544 WEST RIDGEWAY STREET
WARRENTON, NC 27589
PHONE (252) 257-1538
FAX (252) 257-4460

(✓) Provisionally Suitable
( ) Pump system
( ) Repair of existing system
( ) Upgrade

ENTERED 4-19-18 nw

Name of original owner _____
Year _____

Permit No. 8212
Fee $200
Paid 2-26-18
Tax Parcel ID# _____

IMPROVEMENT PERMIT

Owner Ellen Ellis Phone #: 919-691-7259
Address PO Box 846 Littleton NC 27850
Subdivision Name _____ Lot # _____ Block # _____ Section # _____
Directions to lot (RPR#) 158 toward Littleton, Right on John Skinner Rd, bear to right at fork, property on right.

Application Date 2-26-18

— Improvement permit with scale drawing on plat is valid without expiration

✓ **Improvement permit with site plan is valid for 60 months**

IMPROVEMENT PERMIT APPROVAL

Date 3-2-18 _____
Environmental Health Specialist

CONSTRUCTION AUTHORIZATION

Original Deed Date _____ Land Use residence # of bedrooms 2 # of people max 4
Water Supply public water Distance from well and/or water lines 50ft / 10ft
Well installed at time of inspection (✓) Yes ( ) No
Design daily flow of sewage 240 gals.
Septic tank capacity 1000 gals.
Maximum trench depth 36' inches

Dist. from septic system 5ft
Kitchen garbage grinder _____ Other _____
Nitrification field ~~720~~ 675 Sq. Ft.
Type system Gravity / 25% reduction
Type repair Gravity / 25% reduction

CONSTRUCTION AUTHORIZATION APPROVAL

Date 3-5-18 _____
Environmental Health Specialist

***CONSTRUCTION AUTHORIZATION IS VALID FOR 5 YEARS FROM DATE OF ISSUE**

COMMENTS: (1) RUN TRENCHES 3' WIDE AND AT LEAST 9' ON CENTERS (2) RUN LINES CONTOUR TO SLOPE 3) RUN LINES OF EQUAL LENGTH (4) EFFLUENT FILTER REQUIRED 5) TANK MARKERS/RISERS NECESSARY 6) IF TANK LOCATION IS SPECIFIED ON SITE PLAN SEPTIC PERMIT-HOUSE, MH OR STRUCTURE TO BE PLUMBED ACCORDINGLY. 7) INSTALL INITIAL SYSTEM IN DESIGNATED AREA

THE SEPTIC TANK SYSTEM AND OTHER IMPROVEMENTS THAT ARE MADE SHALL BE INSTALLED AS SHOWN IN THE SITE SKETCH PLAN. NO CHANGES SHALL BE MADE WITHOUT APPROVAL FROM THE HEALTH DEPARTMENT.

ANY VARIATIONS FROM THE CONDITIONS AND REQUIREMENTS PREVIOUSLY DESCRIBED WILL VOID THE PERMIT. THIS IS AN OFFICIAL DOCUMENT. PLEASE RETAIN WITH OTHER VALUABLE PAPERS.

***DO NOT LANDSCAPE LOT BEFORE HEALTH DEPARTMENT APPROVAL. DO NOT LOCATE DRIVEWAYS, PARKING AREAS, OR OTHER BUILDINGS OVER SEPTIC TANK SYSTEM. LANDSCAPE AREA OVER SEPTIC TANK SYSTEM TO PREVENT PONDING OF WATER. SEED WITH GRASS TO HELP PREVENT SOIL EROSION AND TO IMPROVE EVAPOTRANSPIRATION.**

OPERATION PERMIT

OPERATION PERMIT APPROVAL

DATE 4-18-18 _____
ENVIRONMENTAL HEALTH SPECIALIST

CONTRACTOR: Tracy Perkinson

NOTE: THE SEPTIC TANK, AND NITRIFICATION FIELD MUST BE INSPECTED BY A REPRESENTATIVE OF THE HEALTH DEPARTMENT BEFORE THEY ARE COVERED.

THE SIGNING OF THIS CERTIFICATE SHALL INDICATE THAT THIS SYSTEM HAS BEEN INSTALLED IN COMPLIANCE WITH THE CURRENT LAW & RULES FOR SANITARY SEWAGE COLLECTION, TREATMENT AND DISPOSAL SET FORTH IN ARTICLE 11 OF GENERAL STATUTE 130A. SECTION. 1900 OF THE NORTH CAROLINA ADMINISTRATIVE CODE TITLE 10, HEALTH SERVICES. ENVIRONMENTAL HEALTH SUBCHAPTER 10A SANITATION AND SHALL IN NO WAY BE A GUARANTEE THAT THE SEPTIC TANK SYSTEM WILL FUNCTION SATISFACTORILY FOR ANY GIVEN PERIOD OF TIME.


WHITE - OWNER'S COPY - YELLOW - HEALTH DEPT. COPY - PINK - INSPECTION DEPT. COPY

Site Plan/System Layout

Applicant Ellen Ellis Subdivision/Lot# _____

Authorized State Agent Amanda Cabiness Date 3-5-18

System components represent approximate contours only. The contractor must flag the system prior to beginning the installation to ensure that proper grade is maintained.

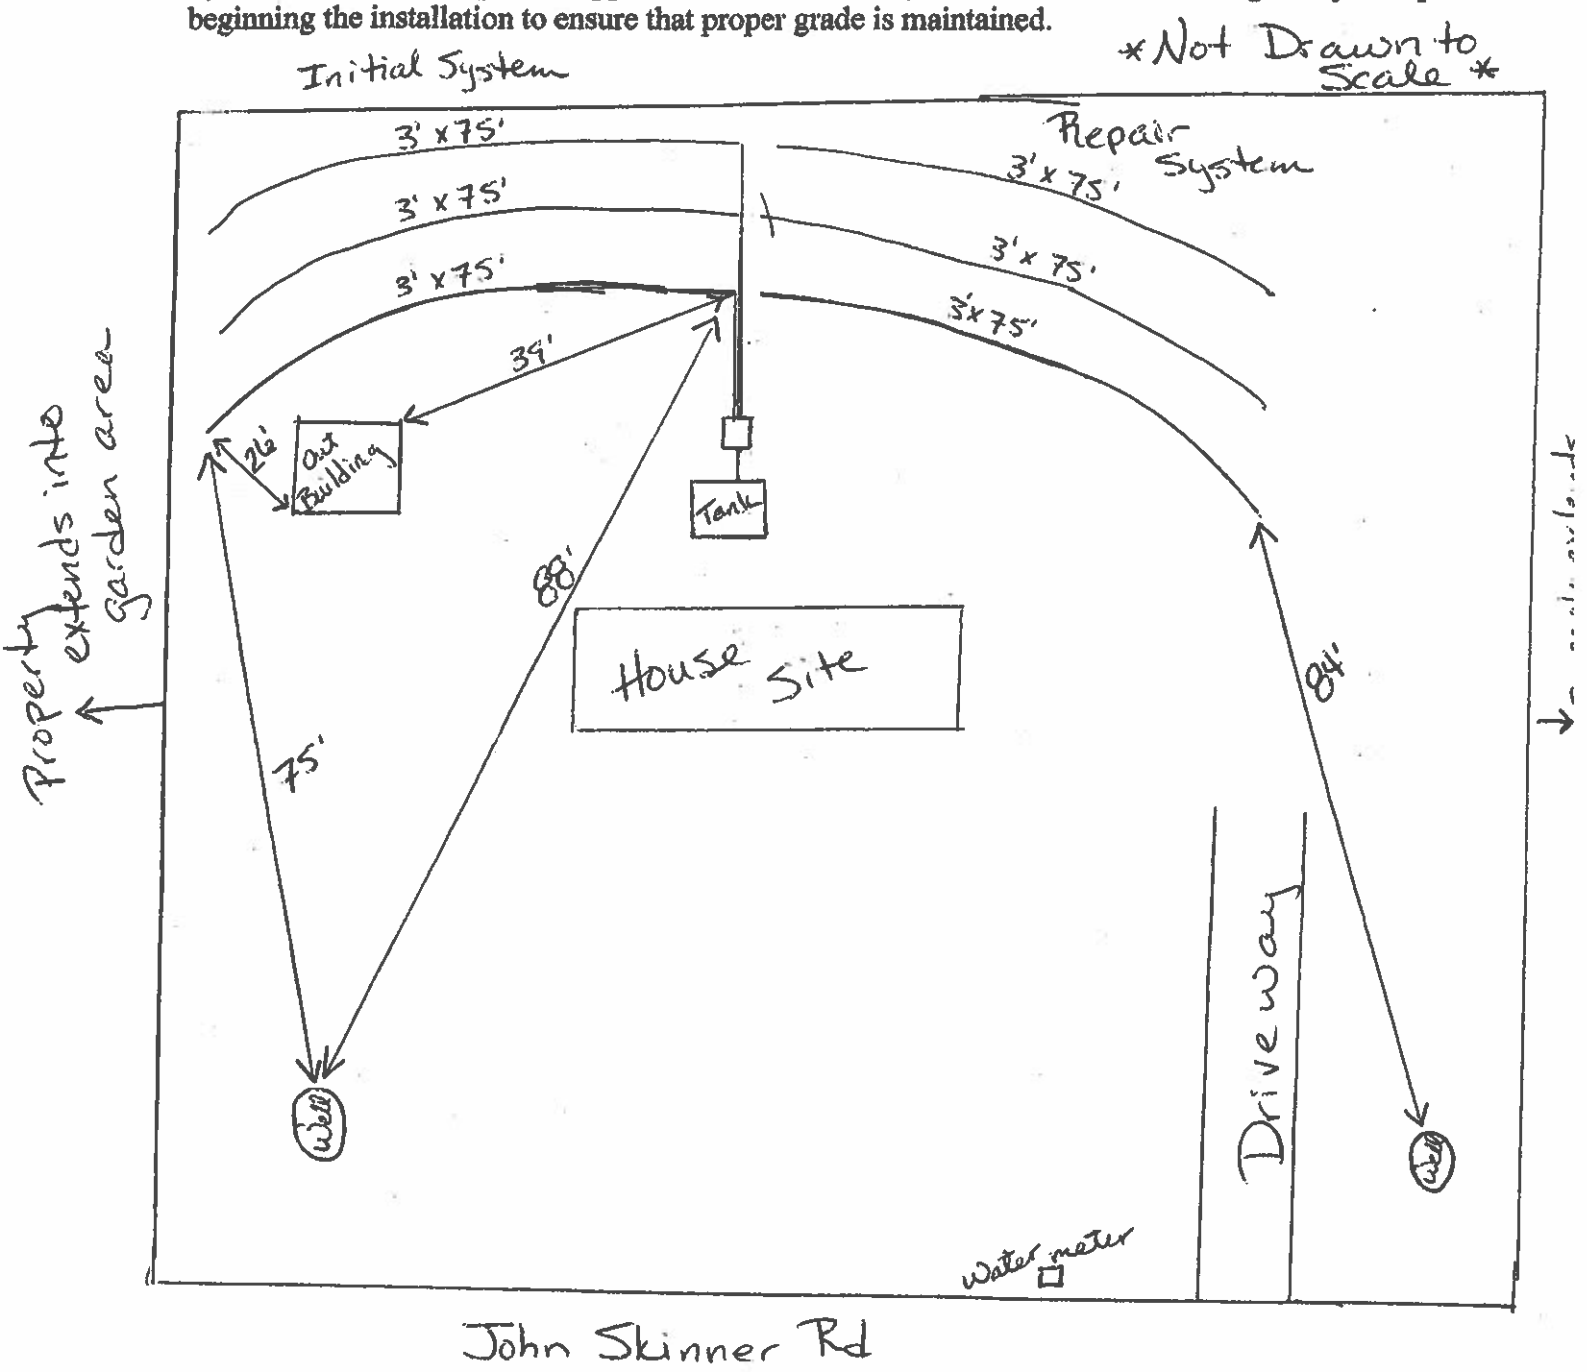

CONDITIONS OF THE PERMIT


Linear feet of conventional trench — Linear feet of 25% reduction trench 225


Maximum trench depth 36" SETBACKS: House foundation – 5 ft; Basement- 15 ft; Well- 50 ft; Property line 10 ft; Stream/Lake- 50ft; Gully- 15ft; Water line- 10ft; Other- _____

Trenches on 9 ft centers, 3 ft wide, on contour, and installed in area shown.

As built

Woodline

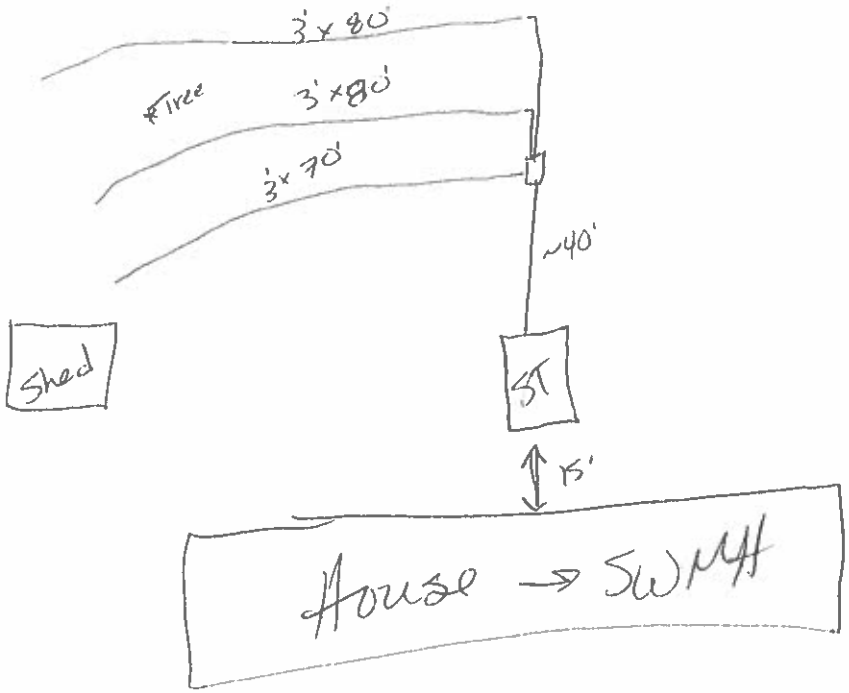

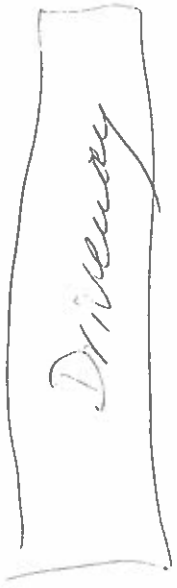

* Well

* Well