Environmental Services - Water Quality
Onsite Wastewater Scan Data Entry Form

PERMIT #: B 0 2 4 3 1 3 PIN #: 1 6 1 9 3 9 4 0 4 7

OP DATE: 0 9 / 2 9 / 1 9 8 3

SYSTEM USE:
- [x] House
- [ ] Mobile Home
- [ ] Business
- [ ] Other

SEWAGE TYPE:
- [x] Domestic
- [ ] Industrial

PUMP/SIPHON?:
- [ ] Yes
- [x] No

PRESSURE MANIFOLD:
- [ ] Yes
- [x] No

SYSTEM TYPE:
- [ ] I
- [x] II
- [ ] III
- [ ] IV
- [ ] V
- [ ] VI
- [ ] Other

SUB TYPE:
- [x] A
- [ ] B
- [ ] C
- [ ] D
- [ ] E
- [ ] F
- [ ] G

NBR BEDROOMS:
- [ ] 1
- [ ] 2
- [x] 3
- [ ] 4
- [ ] 5
- [ ] 6
- [ ] Other

MAINT. SCHEDULE:
- [ ] Yes
- [x] No

CERT. OPERATOR
- [ ] Yes
- [x] No

GT	ST	PT	SIZE
[ ]	[ ]		750
[ ]	[x]	[ ]	900
[ ]	[ ]	[ ]	1,000
[ ]	[ ]	[ ]	1,200
[ ]	[ ]	[ ]	1,500
[ ]	[ ]	[ ]	1,800
[ ]	[ ]	[ ]	2,100
[ ]	[ ]	[ ]	2,500
[ ]	[ ]	[ ]	3,000
[ ]	[ ]	[ ]	4,000
[ ]	[ ]	[ ]	5,000
[ ]	[ ]	[ ]	8,000
	[ ]	[ ]	10,000
[ ]	[ ]	[x]	Other
[x]		[ ]	None/NA GT or PT

DRAINFIELD SIZE(SQ. FT.)

0 1 2 0 0

DRAIN TYPE:
- [x] Stone
- [ ] EZ Flow
- [ ] Infiltrator
- [ ] Biodiffuser
- [ ] Cultec
- [ ] Drip
- [ ] Hancor
- [ ] Large Dia. Pipe
- [ ] Multi-Pipe
- [ ] Other

MAX DEPTH (IN.):
- [ ] 12 in. or less
- [ ] 18 in. or less
- [ ] 24 in. or less
- [ ] 26 in. or less
- [ ] 28 in. or less
- [ ] 30 in. or less
- [ ] 32 in. or less
- [ ] 36 in. or less
- [x] Other

STONE DEPTH (IN.):
- [ ] 8 in. or less
- [x] 12 in. or less
- [ ] 18 in. or less
- [ ] 24 in. or less
- [ ] Other

TRENCHES:
- [x] Individual
- [ ] Bed

TRENCH WIDTH (IN.):
- [ ] 12 in. or less
- [ ] 18 in.
- [ ] 24 in.
- [x] 36 in.
- [ ] 6 ft. or less
- [ ] 9 ft. or less
- [ ] Other

GARNER

WAKE COUNTY HEALTH DEPARTMENT SEPTIC TANK LAYOUT AND PERMIT

11:30

VA- 11-17-83

TAX MAP NO. 74K PARCEL NO. 134 PERMIT NO. B 24313

CONTRACTOR

Building Permit # 83-228

OWNER Ronnie Ricks DATE 6-17-83

LOCATION

S. R. NO. 2711

SUBDIVISION NAME Duxhaven by the Lake LOT NO. 92 SECTION OR BLOCK NO.

REPAIR ☐ ORIGINAL PERMIT NO.

GARBAGE DISPOSAL UNIT YES ☐ NO ☒

HOUSE ☒ MOBILE HOME ☐ BUSINESS ☐

NO. BEDROOMS 3 LOT AREA .92Ac.

SIZE OF TANK 900 gal.

NITRIFICATION LINE 1200 (3/3'x133') sq. ft.

DEPTH OF STONE IN LINES: 12" ☐ 18" ☐

RISER AND BAFFLE REQUIRED ☐ PUMP REQUIRED ☐

WATER SUPPY: INDIVIDUAL ☐ PUBLIC ☐ OTHER ☐

* PERMIT VOID 36 MONTHS FROM DATE OF ISSUANCE.
* PERMIT VOID IF NOT IN COMPLIANCE WITH ZONING REGULATIONS
* PERMIT MAY BE VOIDED IF SITE ALTERATIONS MADE

LAYOUT BY L.F.Quin R.S.

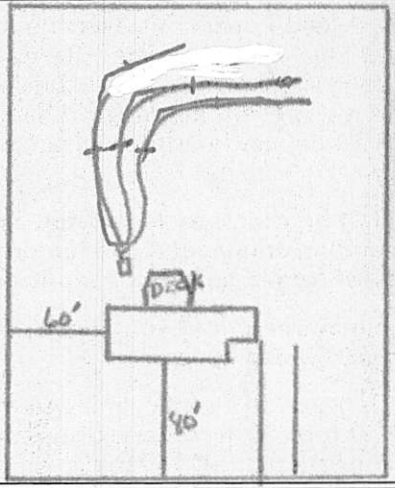

STB-519
MITCHELL

590-GP09

9-29-83
DATE

KORNEGAY
INSTALLED BY

SR 2711 L.F.Quin, R.S.
APPROVED BY